


6-9770
58414

T. 41 S., R. 20 E., W. M.

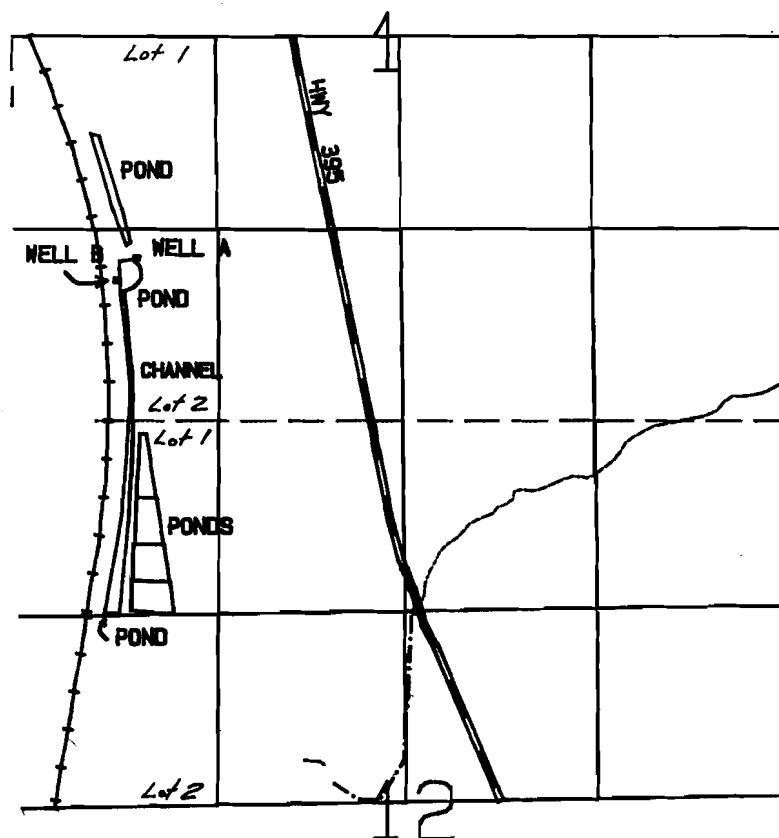

SCALE: 1" = 1320'

WELL A LOCATED 1120 FT. N. AND 1820 FT. W. FROM S1/4 COR. SEC. 1

WELL B LOCATED 960 FT. N. AND 1950 FT. W. FROM S1/4 COR. SEC. 1

FINAL PROOF SURVEY
UNDER

APPLICATION NO. 6-9959 PERMIT NO. 6-9770

IN NAME OF
LEMMIE ROCKFORD

Surveyed Oct. 19, 1987 By V.L. CHURCH

Photo: 38K-182 & PTS JCI