


T.38 S., R.19 E., W.M.

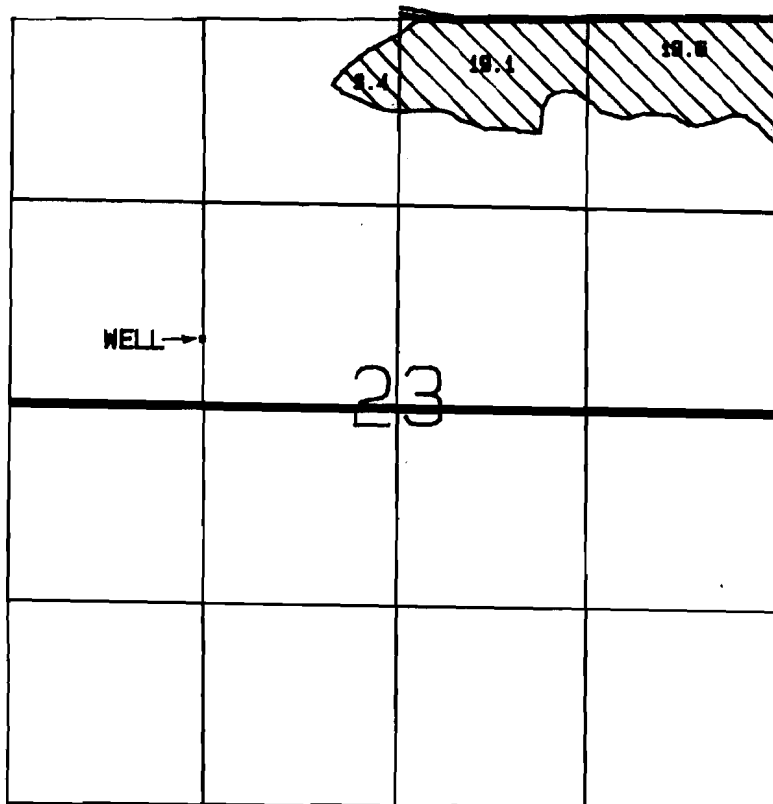

SCALE: 1 = 1320

WELL. LOCATED 2200 FT. S. AND 1280 FT. E. FROM NW COR. 23

FINAL PROOF SURVEY  
UNDER

Application No. 6-11393 Permit No. 6-10503

IN NAME OF

KINGS TREE COMPANY

Surveyed Oct. 19, 1987 By B.S. JAMES