


# T. 39S., R. 1E., W.M.

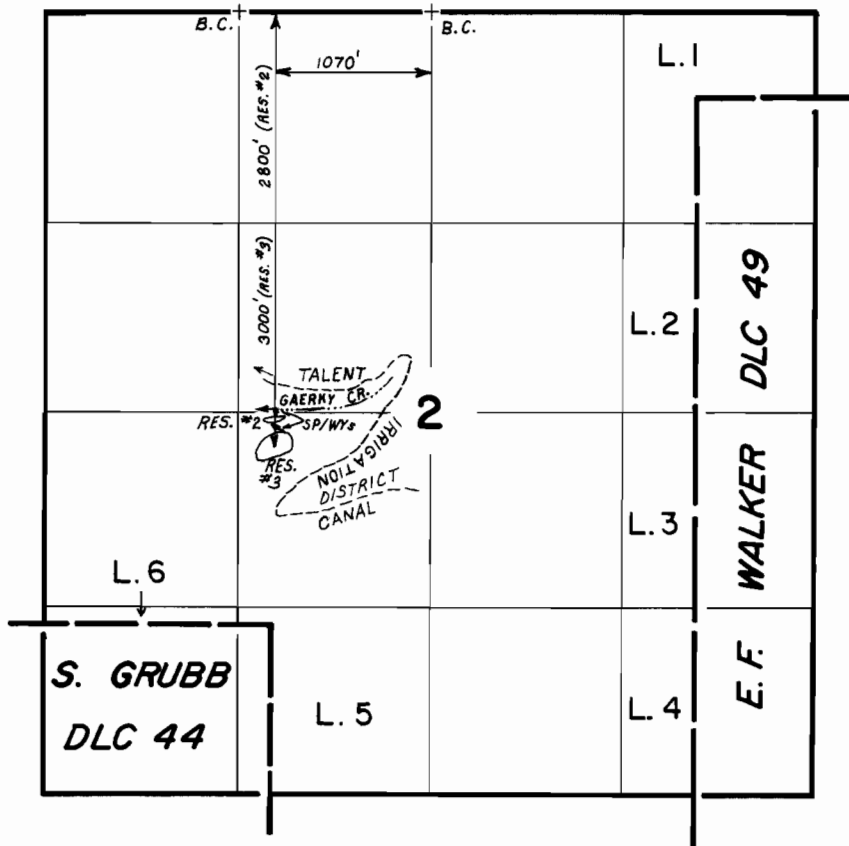

SCALE: 1" = 1320'

## FINAL PROOF SURVEY

UNDER

R-52497

R-6377

Application No. .... Permit No. ....  
IN NAME OF

J. W. DEWITT

Surveyed JUNE 7, 1984, by B. S. JAMES