
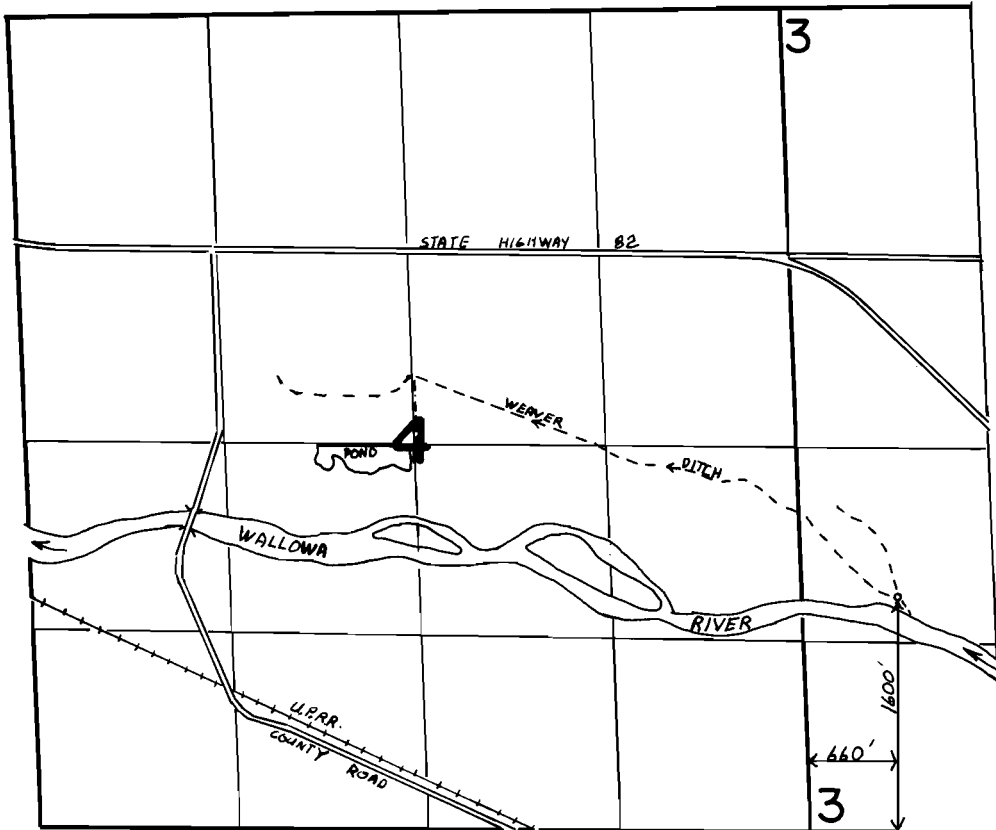


T. 1N., R. 42E., W.M.

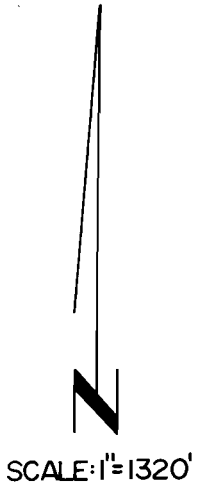

FINAL PROOF SURVEY UNDER

R-50031 R-6422
 Application No. 53032... Permit No. 40313.....
 IN NAME OF

OREGON WILDLIFE COMMISSION

Surveyed Aug. 12..... 1985., by V.L. CHURCH.....