


T.5S.R.9W.W.M.

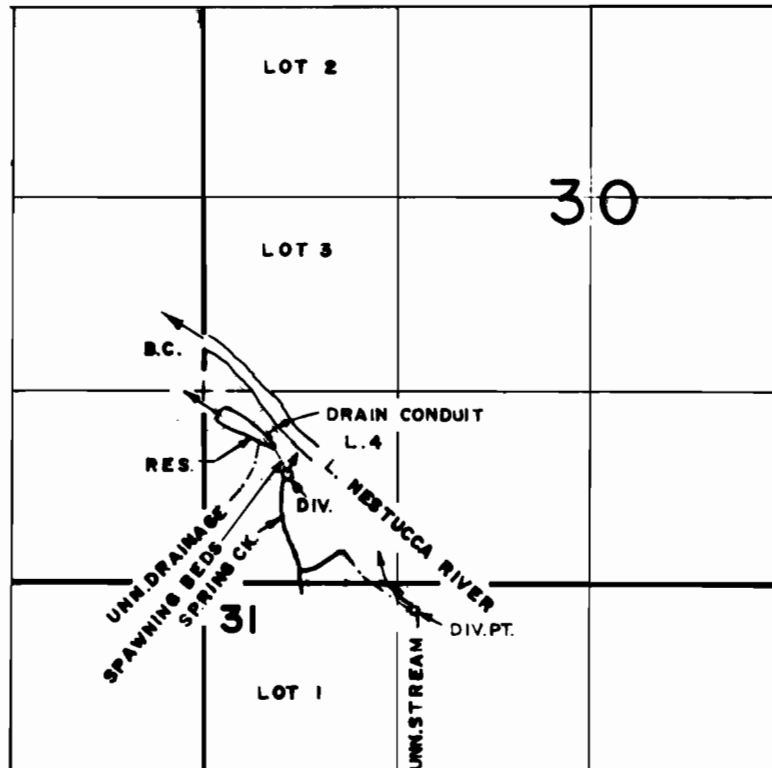

DIV. PTS. LOC: SPRING CK.- 740' N. & 580' E.,
UNN. STR.- 200' S. & 1340' E.,
UNN. DR. & RES.- 1160' N. & 100' E.;
ALL FROM S.W. COR. SEC. 30

FINAL PROOF SURVEY UNDER

R-55691 R-6646
Application No. ~~54968~~ Permit No. ~~41979~~.....
IN NAME OF

.....ROBERT L. BAIRD.....

Surveyed JAN. 23. 1980, by R.G. MUCKEN.....