


T.4S.,R.3W.,W.M.

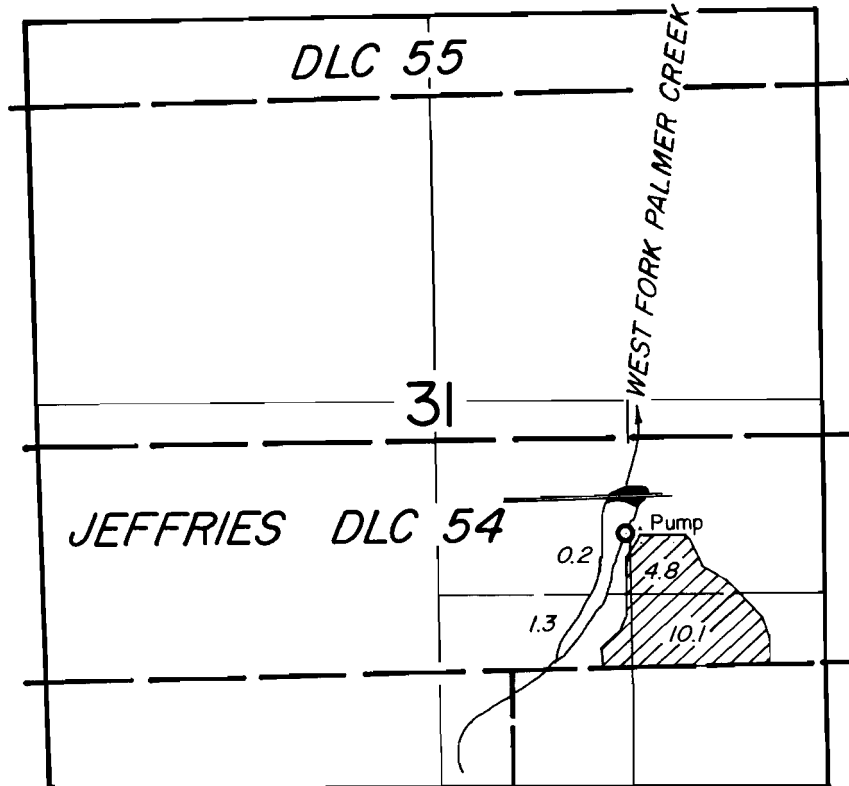

DAM LOCATED: 2000 H. N. & 1350 H. W. FROM THE
SE CORNER SECTION 31.

FINAL PROOF SURVEY
UNDER

R-56672 R-6728
Application No. 56673 Permit No. 42465.....
IN NAME OF

Donald E. Youngblood

Surveyed MAY 10, 1979, by Al Bann.....