


T.4S.,R.3W.,W.M.

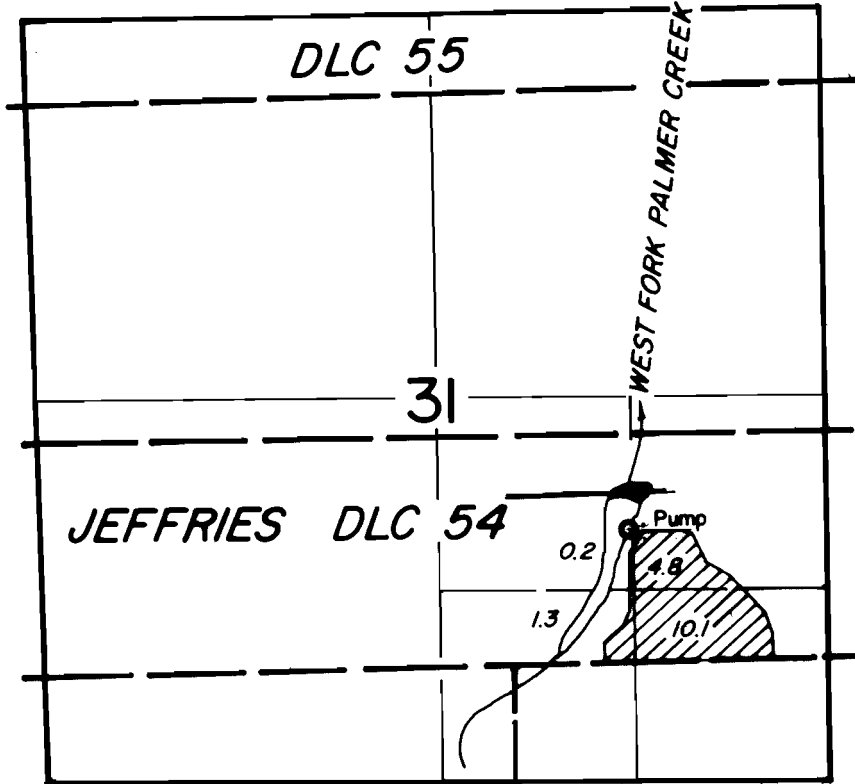

DAM LOCATED: 2000 H. N. & 1350 H. W. from the SE corner Section 31.

**FINAL PROOF SURVEY**  
UNDER

R-56672                      R-6728  
Application No. 56673 Permit No. 42465.....  
IN NAME OF

Donald E. Youngblood.....

Surveyed MAY 10, 1979, by Al Bann.....