


T. 2 S., R. 5 W. WM.

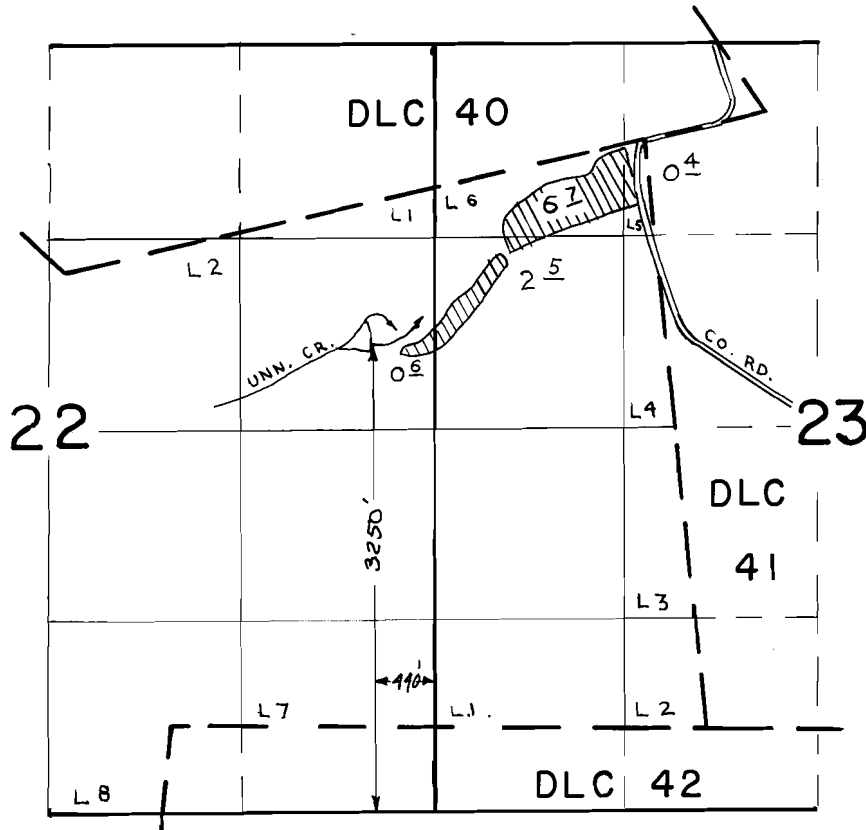

FINAL PROOF SURVEY UNDER

R 56999 R 6771
 Application No. 57000 Permit No. 42703.....
 IN NAME OF

..... PAUL MARTIN

Surveyed SEP. 19. 1984, by P. PAGTER.....