


T. 2S., R. 38E., W.M.

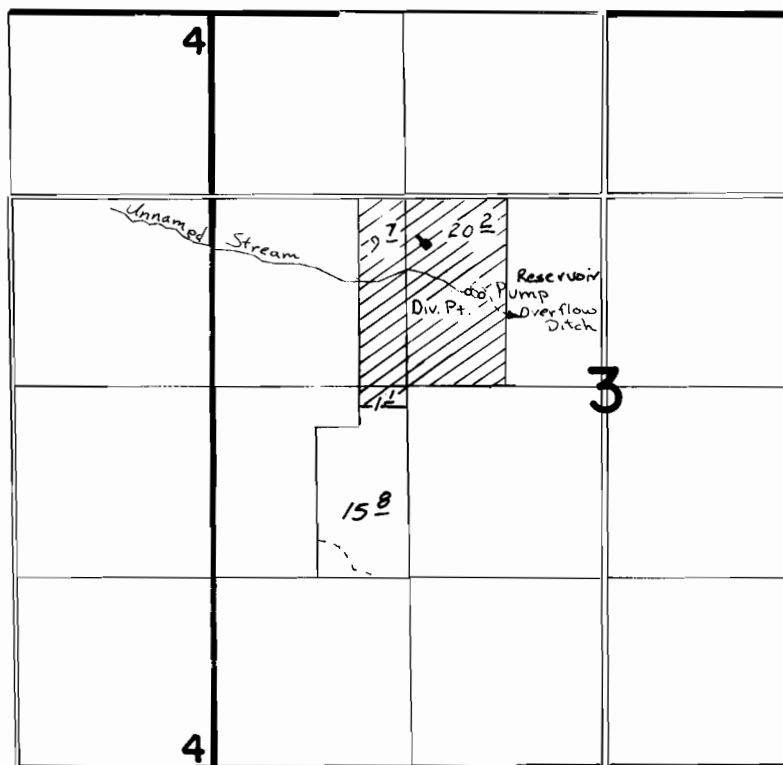

Div. Pt. Loc: 650' N. & 1750' E. From W 1/4 Cor. Sec. 3

FINAL PROOF SURVEY
UNDER

R-56704 R-6773
Application No. **56703** Permit No. **42713**
IN NAME OF

.....**JOHN SCOTT HARVEY**.....

Surveyed *Aug. 23, 1983*, by *V. L. Church*.....