


T. 38 S., R. 5 W., W.M.

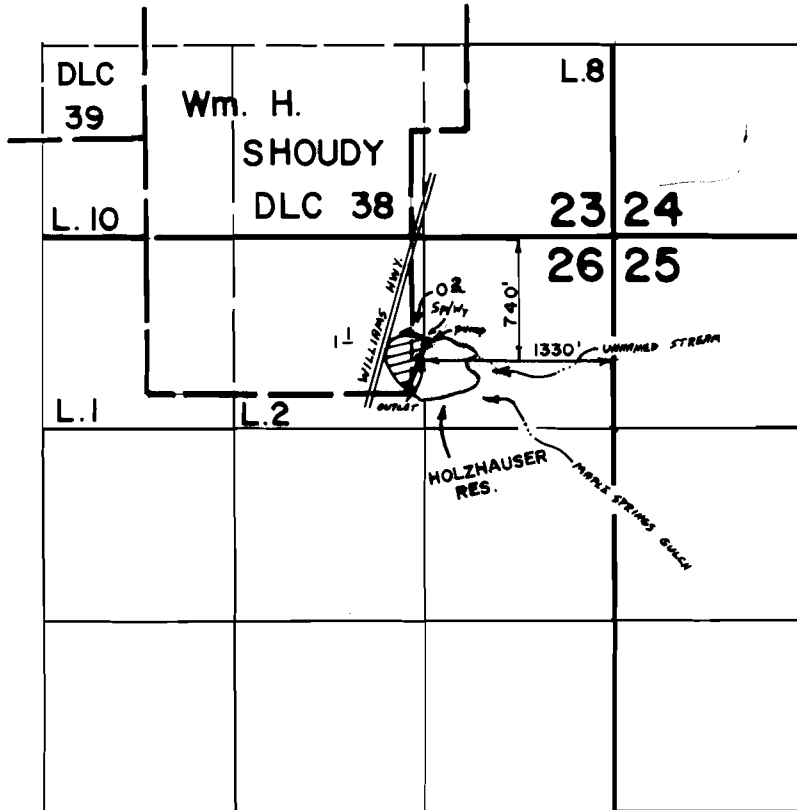

FINAL PROOF SURVEY UNDER

Application No. R-57062 57063 Permit No. R-7701 43463
IN NAME OF

JANEEN V. ARMBRUSTER

Surveyed Aug. 4., 1983., by B.S. JAMES.....

SCALE : 4 " = 1 MILE