


T.2N.R.11E.W.M.

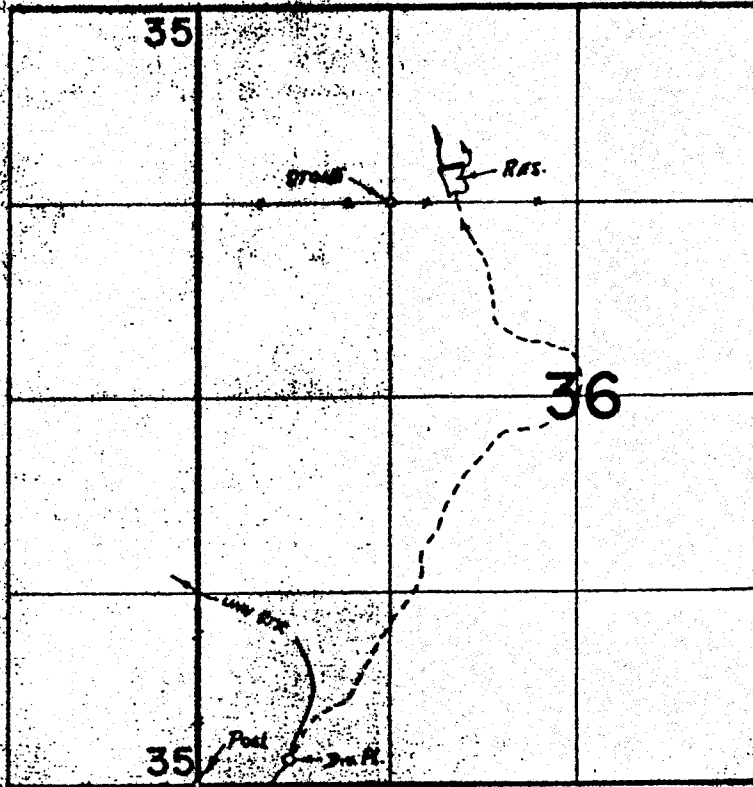

DIV. PT. LOC. $170^{\circ} N \ 630' E$ FROM THE SW COR. SEC 36
RES. LOC. $150' N \ 1450' E$ FROM THE SW COR. NE 1/4 NW 1/4 SEC 36

FINAL PROOF SURVEY UNDER

R-57995

R-7995

Application No. 57979 Permit No. 44674

IN NAME OF

GILBERT WILEY

Surveyed Oct. 25, 1983, by T.J. Paul