

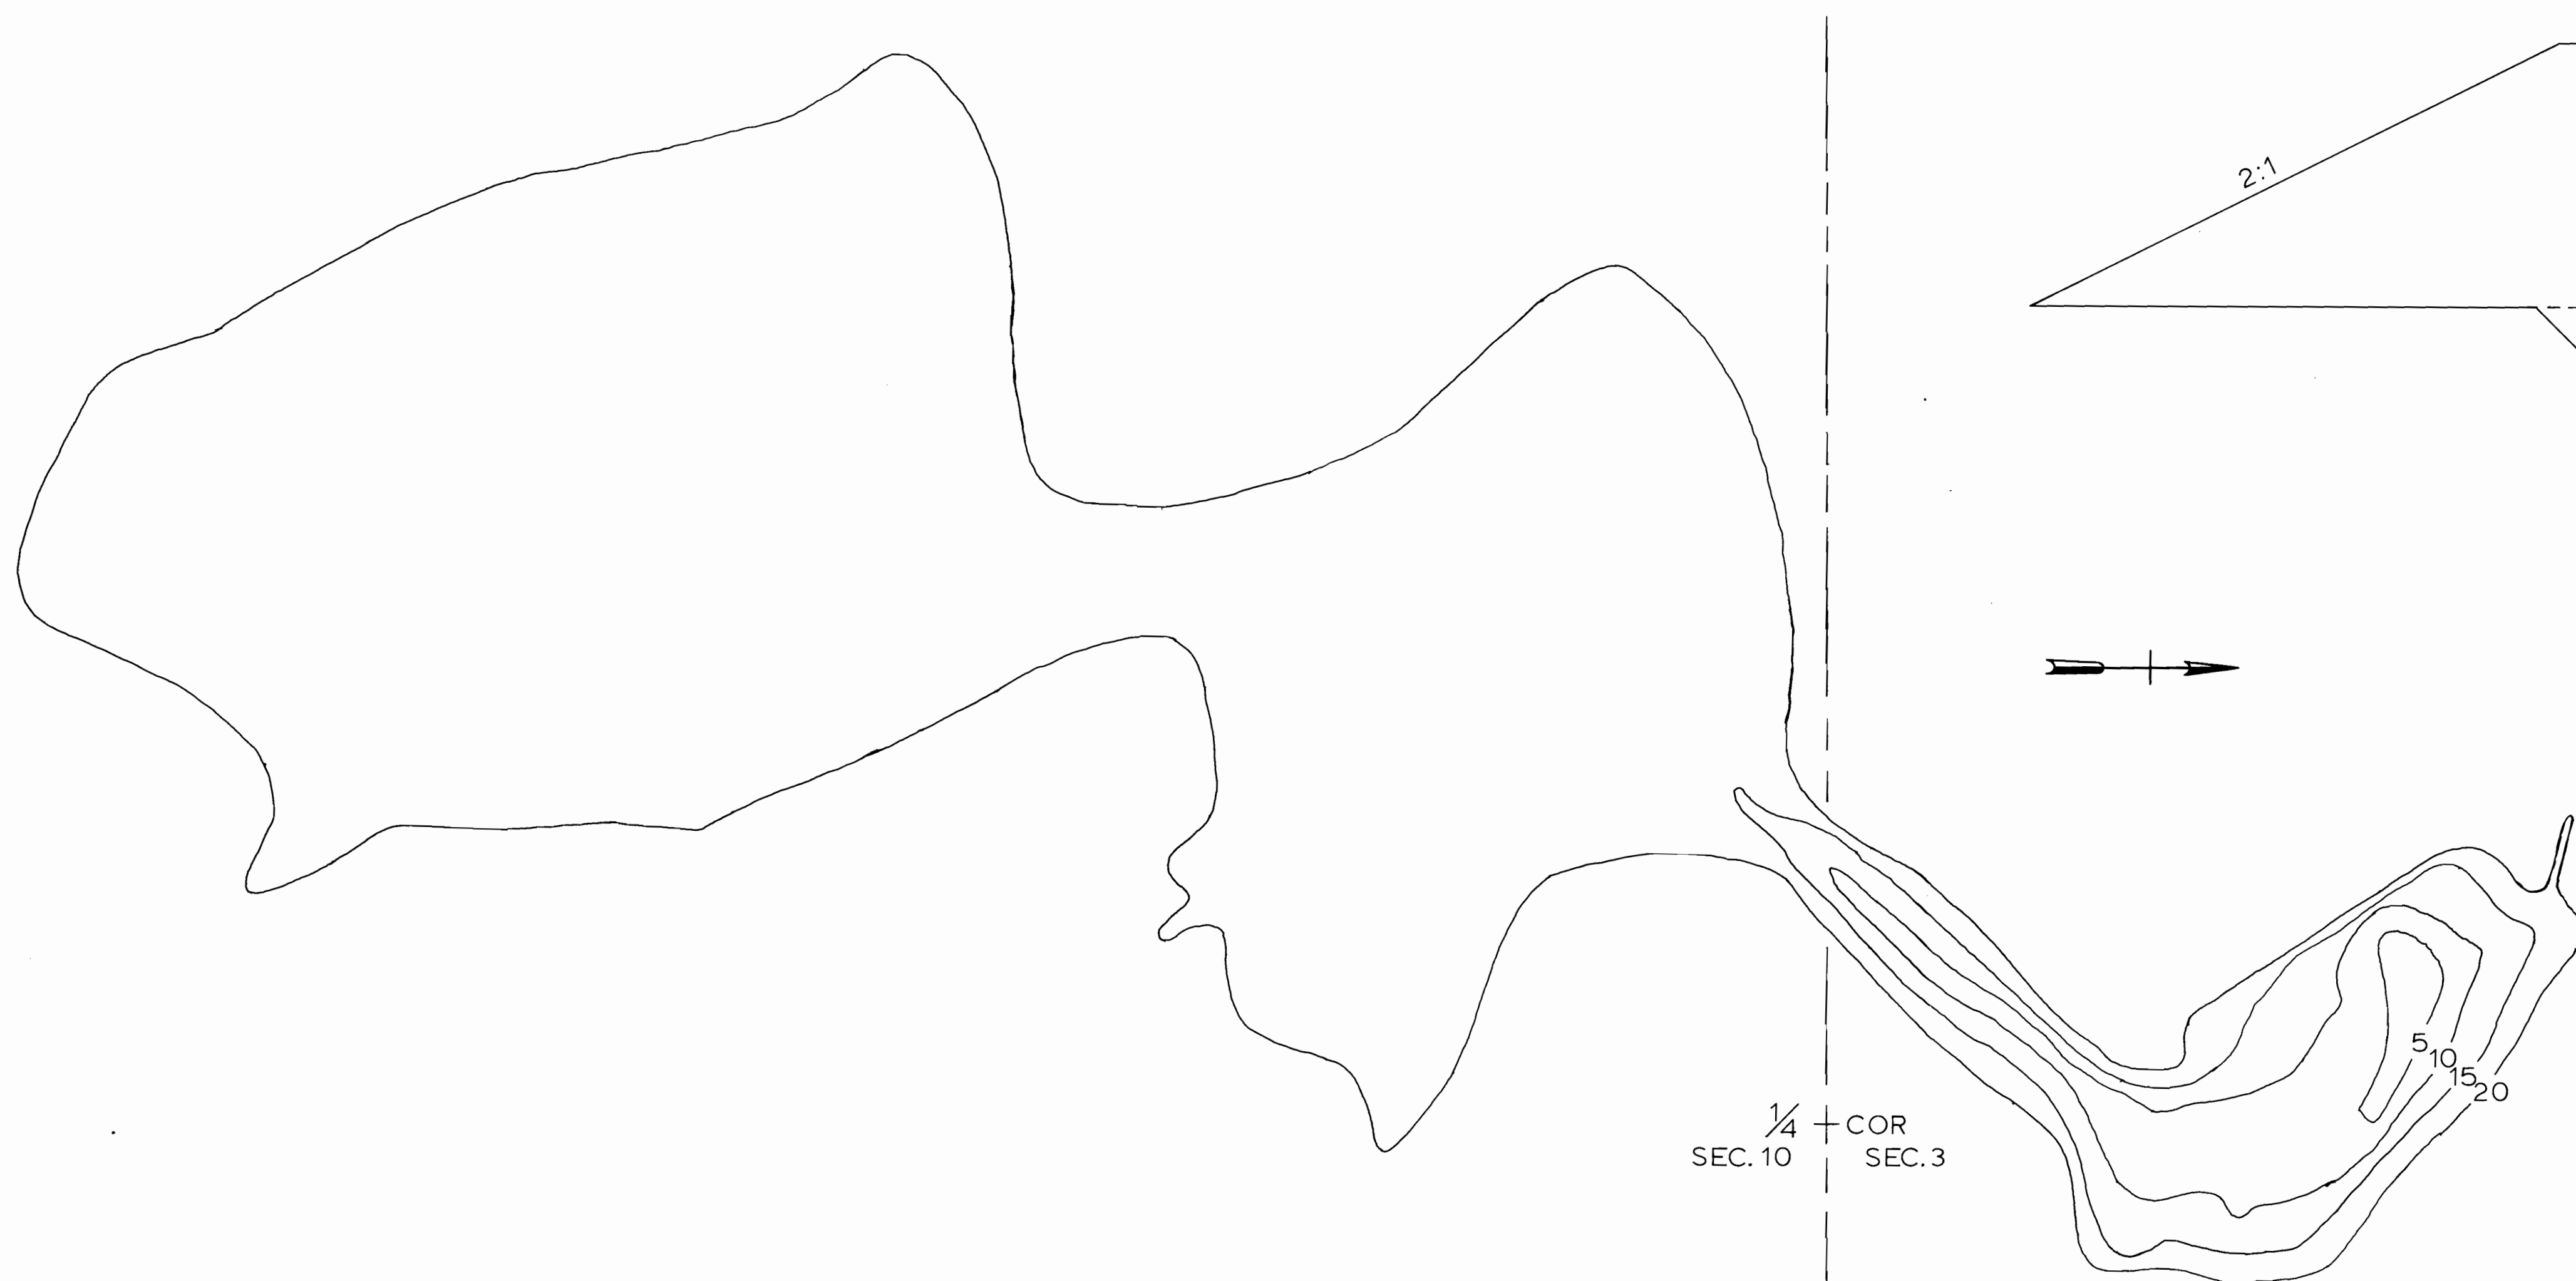


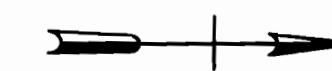

T.40S. R.23E. WILL. MER.
LAKE COUNTY OREGON

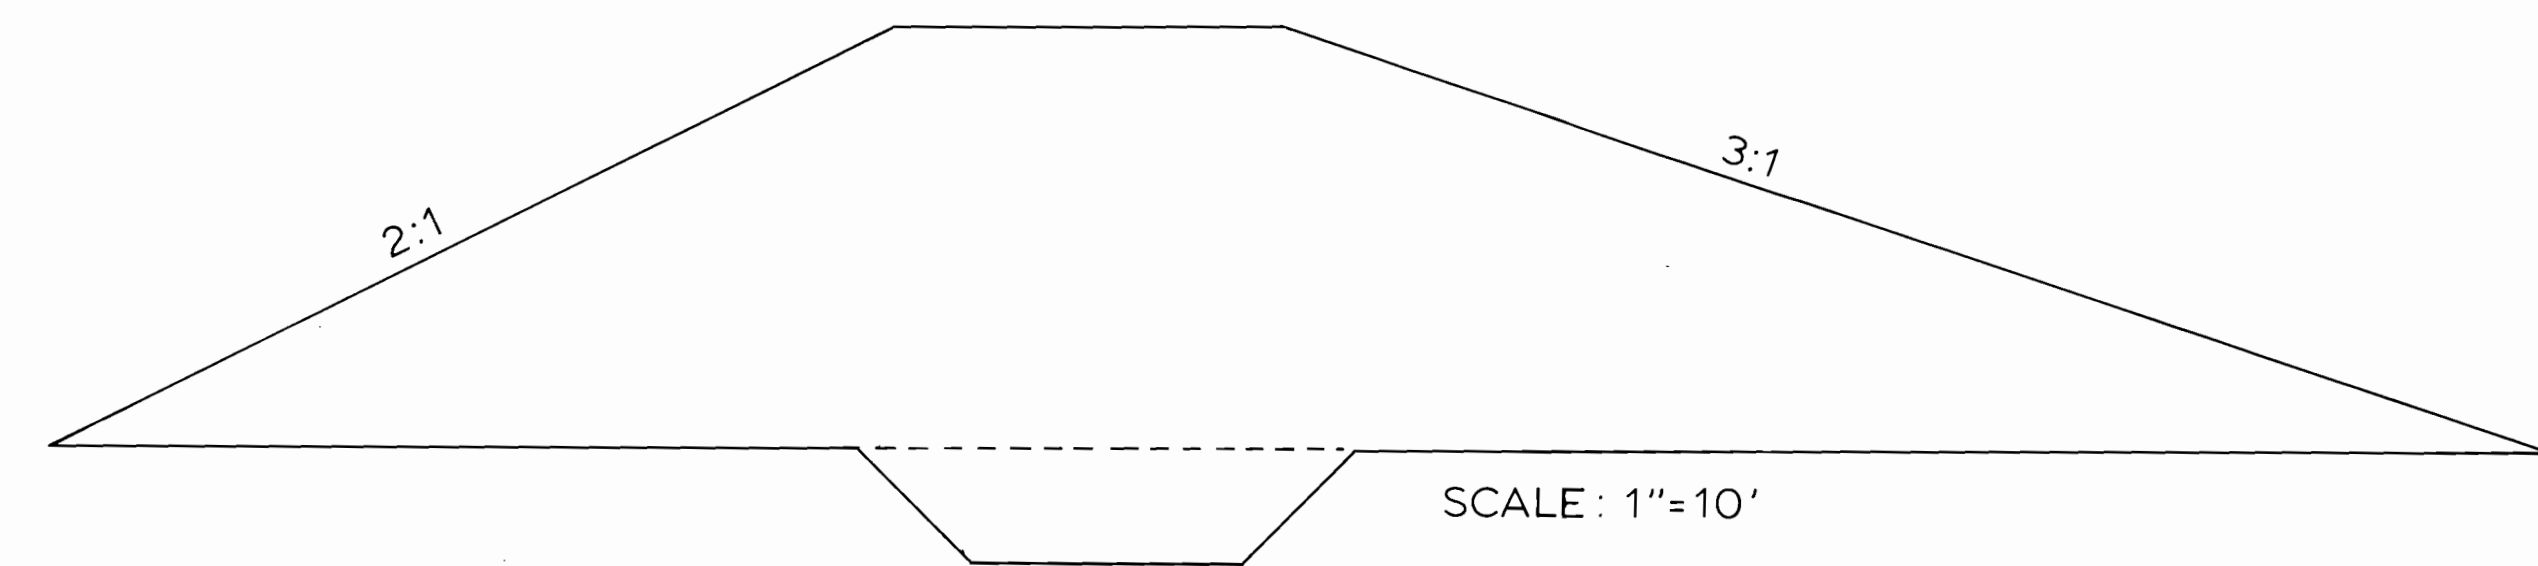

CONTOUR	AREA (ACRES)	ACRE FEET
20	68.99	190.73
15	7.30	27.23
10	3.59	10.13
5	0.46	
TOTAL		228.09

END OF DAM IS 1180' N. AND 390' W. OF 1/4 COR. SEC. 3+10

UNITED STATES DEPARTMENT OF THE INTERIOR BUREAU OF LAND MANAGEMENT	
LAKEVIEW DISTRICT	OREGON
LUCKY RES. #1136	
DESIGNED _____	RECOMMENDED _____
DRAWN BV	RECOMMENDED _____ CHIEF DIV. OF ENGINEERING
CHECKED _____	APPROVED _____
SCALE 1"=200'	
DATE 3-7-79	SHEET 1 OF 1
DRAWING NO.	

R-53-11 & 59715
R 8-77