


T. 28S., R. 6W., W.M.

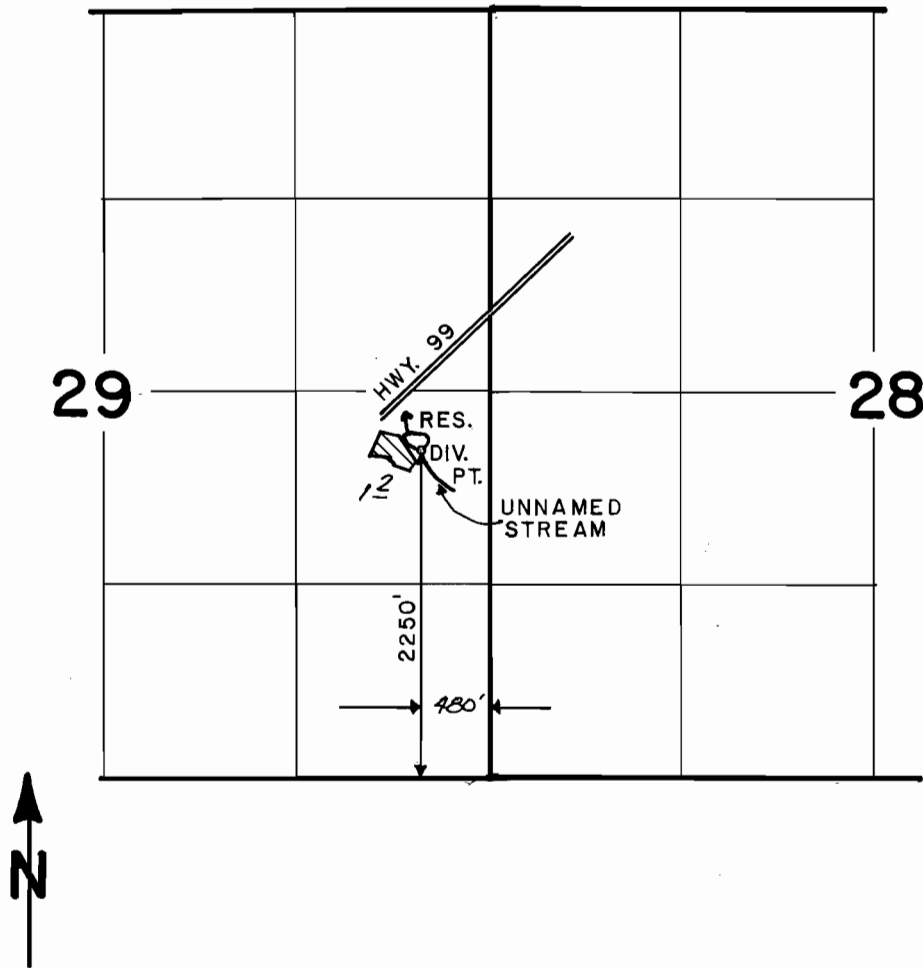

SCALE: 4" = 1 MILE

FINAL PROOF SURVEY UNDER

R-58848 R-8130
 Application No. 58849 Permit No. 44840....
 IN NAME OF

WILMA A. MOORE & NANCY J. SPENCER

Surveyed DEC. 6 1983, by L. E. CASHION....