T.2S.,R.1W.,W.M.

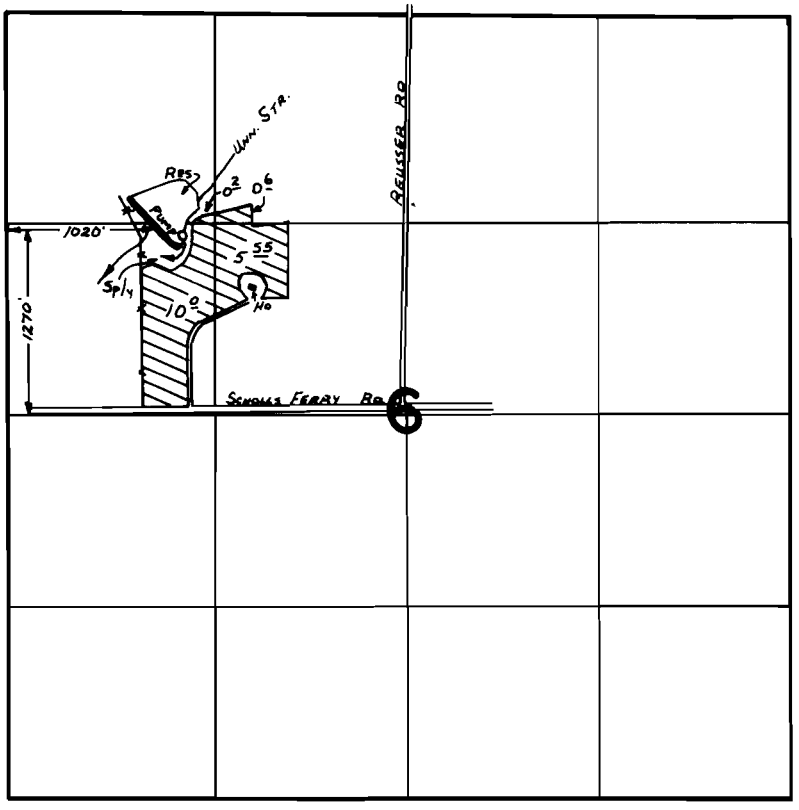

SCALE: 1" = 1320'

FINAL PROOF SURVEY
UNDER

R-60443 R-8179
Application No. 60444 Permit No. 45100
IN NAME OF

BARBARA P. McFARLAND

Surveyed Nov. 17 19 83, by L. M. TOLL

DFR-10-94 ZOOM
PTS 1983-X