


T.2S.,R.1W.,W.M.

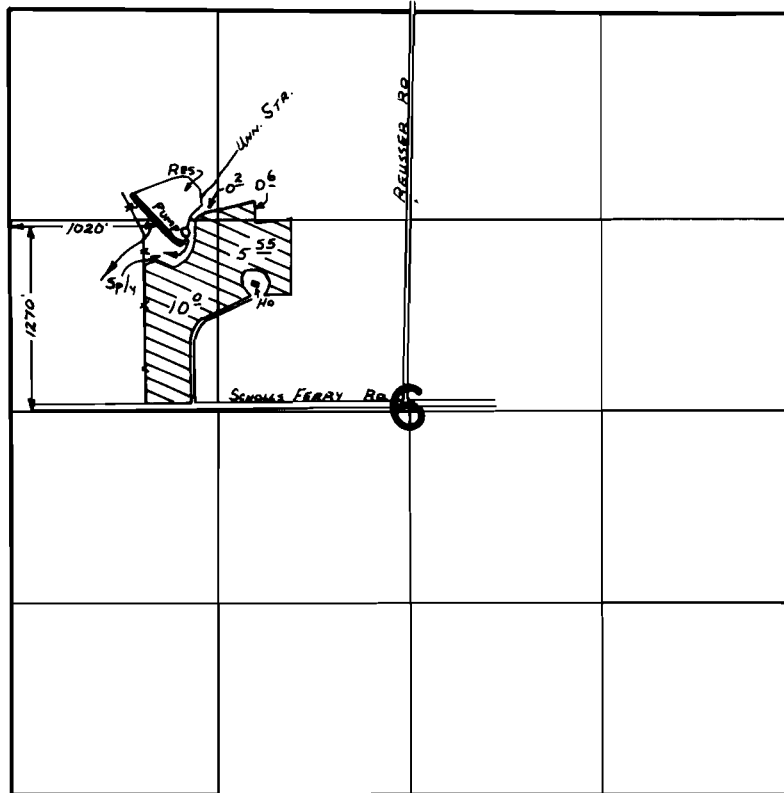

SCALE: 1"=1320'

FINAL PROOF SURVEY
UNDER

R-60443 R-8179
Application No. 60444.. Permit No. 451.00.....
IN NAME OF

.....BARBARA P. McFARLAND.....

Surveyed Nov. 17..... 19.83, by L.M. TOLL.....