


T.7S.,R.5W.,W.M.

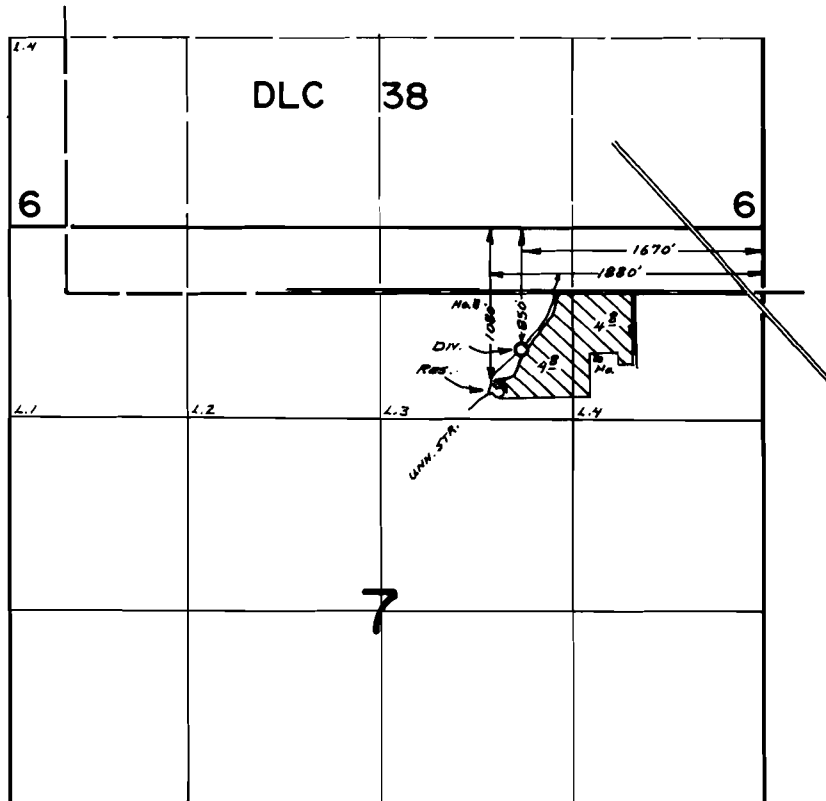

FINAL PROOF SURVEY

UNDER

R-60160 R-8230
Application No. .60161... Permit No. .45507.....
IN NAME OF

.....MARVIN...MAY.....

Surveyed .Oct...13.. 19.81., by ..L...TOLL.....