


# T.7S.,R.5W.,W.M.

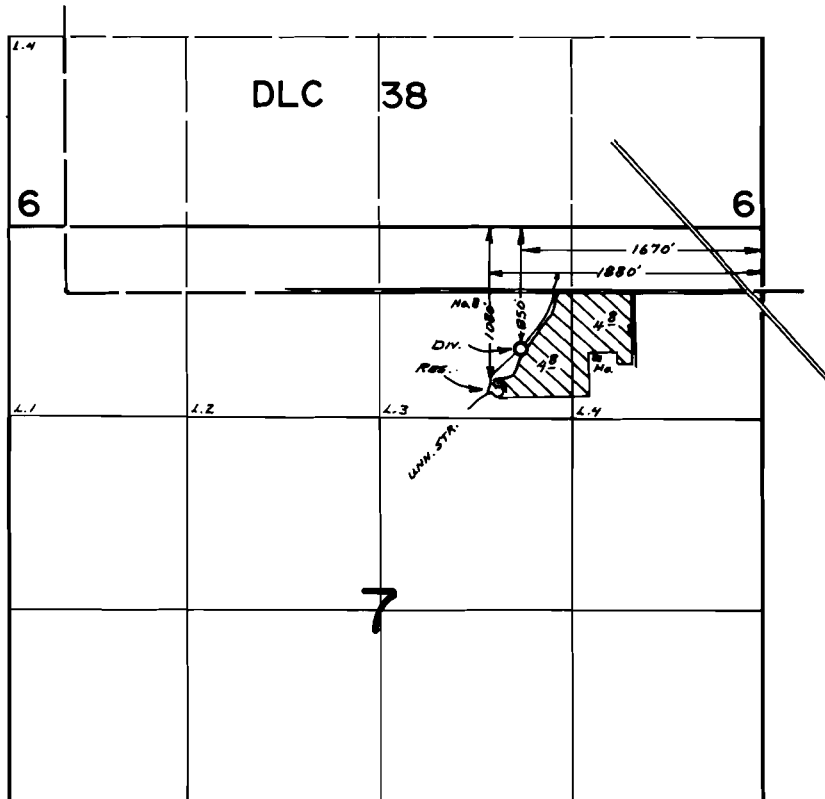

## FINAL PROOF SURVEY UNDER

R-60160                      R-8230  
Application No. 60161... Permit No. 45507.....  
IN NAME OF

.....**MARVIN MAY**.....

Surveyed Oct. 13, 1981, by L. T. OLL.....