

STATE OF OREGON

COUNTY OF UNION


PROPOSED CERTIFICATE OF WATER RIGHT

KENNETH D. AND JEANETTE S. KNOTT,
of ROUTE 1, BOX 31D, COVE, OREGON 97824, has constructed a reservoir
to store the waters of MILLARD BRANCH, a tributary of MILL CREEK
APPROPRIATED UNDER PERMIT 45621, for the purpose of FISH ENHANCEMENT &
LIVESTOCK WATER.

The right to store these waters has been perfected under Reservoir
Permit R-8254. The date of priority is MARCH 25, 1981. The amount of
water entitled to be stored each year under such right is not more
than 0.4 ACRE-FOOT.

The reservoir is located as follows:

NW 1/4 NW 1/4
SECTION 26
TOWNSHIP 34 SOUTH, RANGE 40 EAST, W.M.

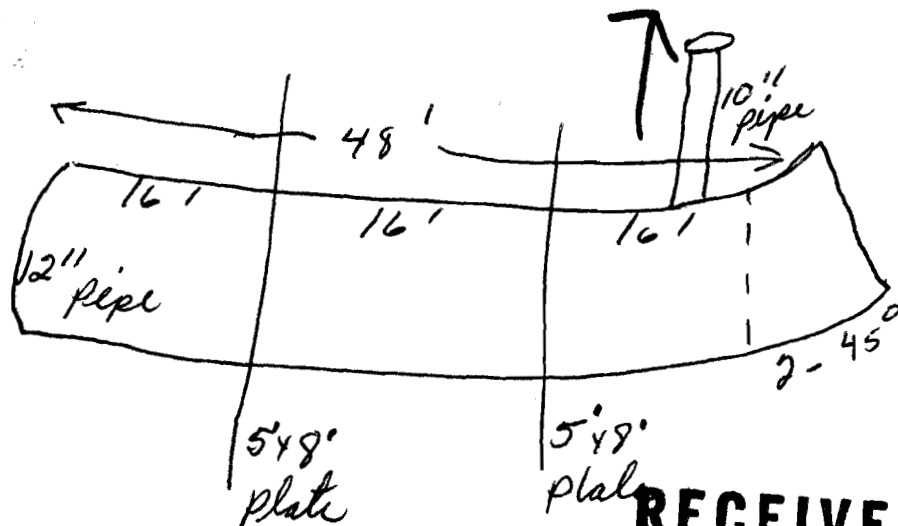

Drain Pipe


RECEIVED

AUG 12 1981

WATER RESOURCES DEPT
SALEM, OREGON

The right to store and use the water for the above purpose is
restricted to beneficial use at the place of use described.

T. 3S., R. 40E., W. M.

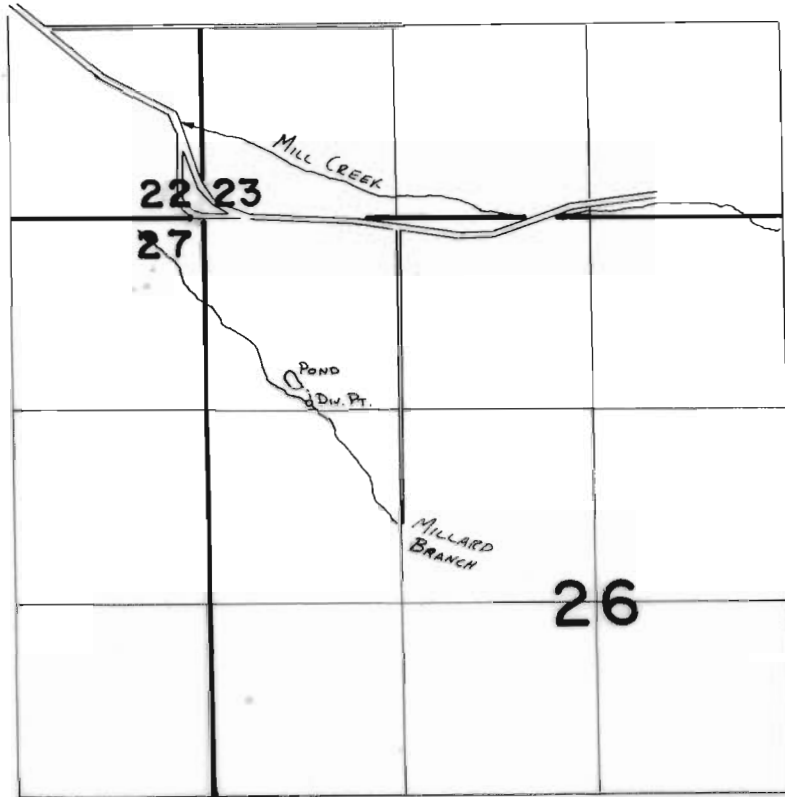

Div. Pt. Loc: 1250'S. & 700'E. FROM NW COR. SEC. 26

SCALE 1" = 1320'

FINAL PROOF SURVEY
UNDER

Application No. **61282** Permit No. **45651**
R:61439 **R:8254**
IN NAME OF

KENNETH D. & JEANETTE S. KNOTT

Surveyed 7-11 1984, by V.L. Church