


T. 3S., R. 40E., W.M.

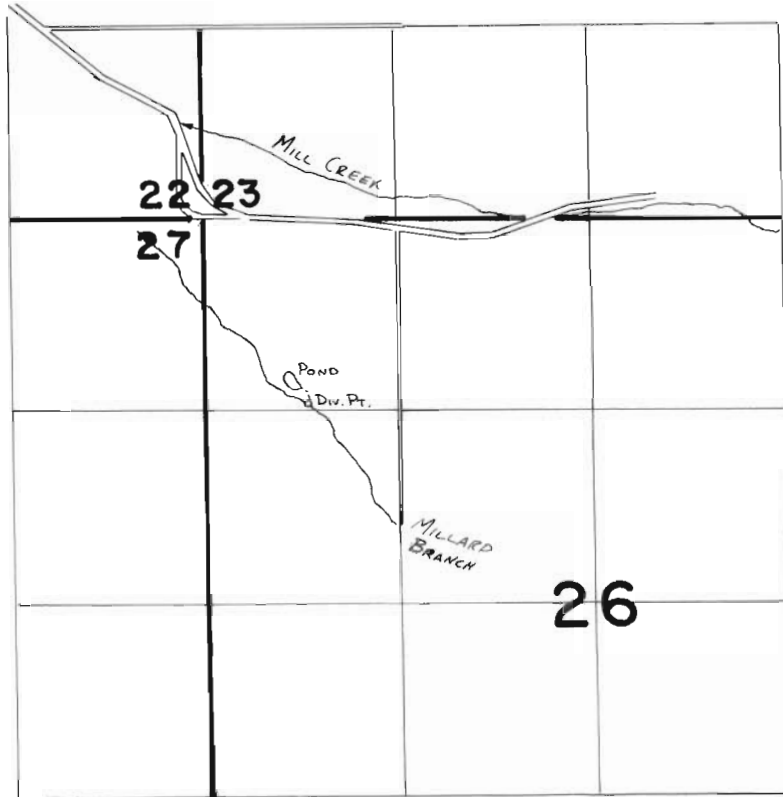

Div. Pt. loc. 1250'S. & 700'E. FROM NW COR. SEC. 26

SCALE 1" = 1320'

FINAL PROOF SURVEY
UNDER

Application No. **61282** Permit No. **45651**
R-61439 **R-8254**
IN NAME OF

KENNETH D. & JEANETTE S. KNOTT

Surveyed 7-11 1984, by V.L. Church