


T.25S., R.5W., W.M.

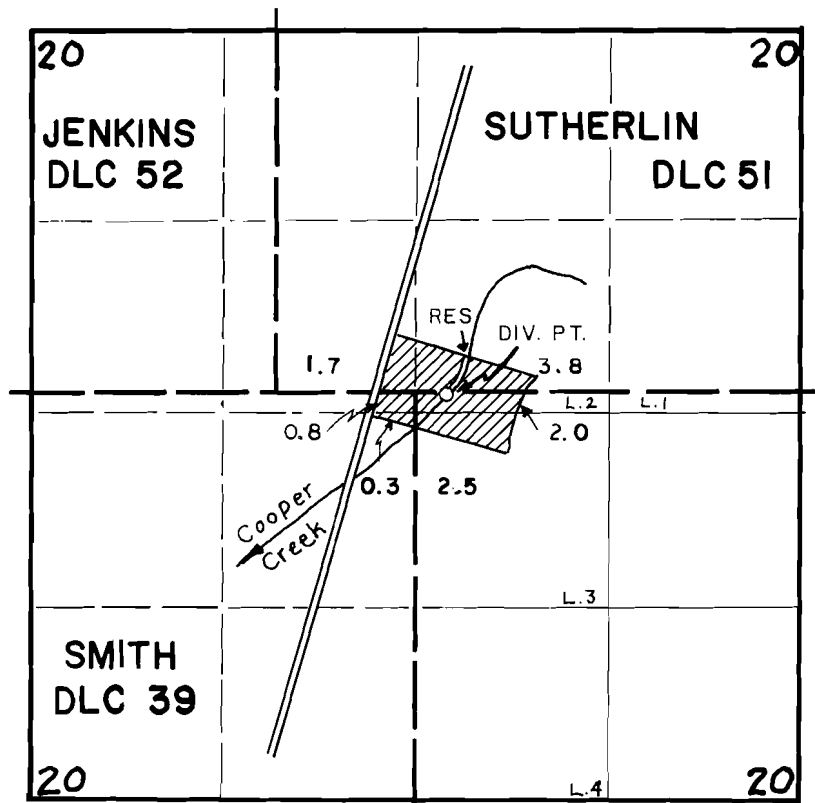

DIV. PT. IS LOCATED 10'S. & 1150' E. FROM SW COR. DLC 51.



SCALE: 4" = 1 MILE

FINAL PROOF SURVEY UNDER

R-61890 R-8370
 Application No. 61891..... Permit No. 46508.....
 IN NAME OF

TONY STANLEY

Surveyed JULY 1, 1986, by J. M. SCHMORDE