


T. 35 S., R. 2 W., W. M.

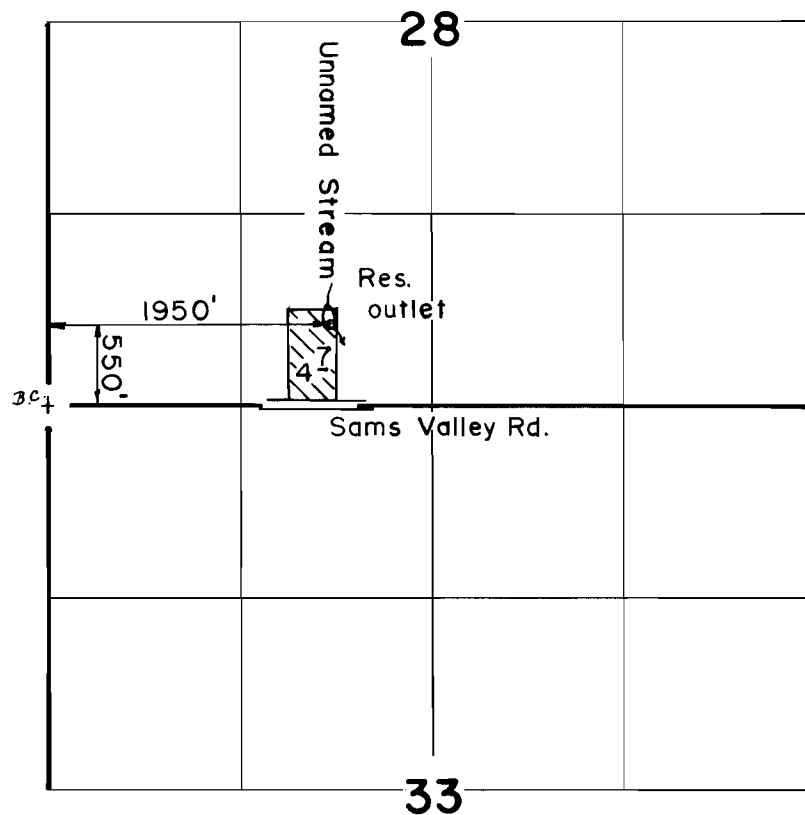

FINAL PROOF SURVEY
UNDER

R-62182

R-8463

Application No. 62183 Permit No. 46843
IN NAME OF

MELVIN D. KIGHT

Surveyed MAY 30 1986, by B. S. JAMES