


T. 2 N., R. 9 W., W.M.

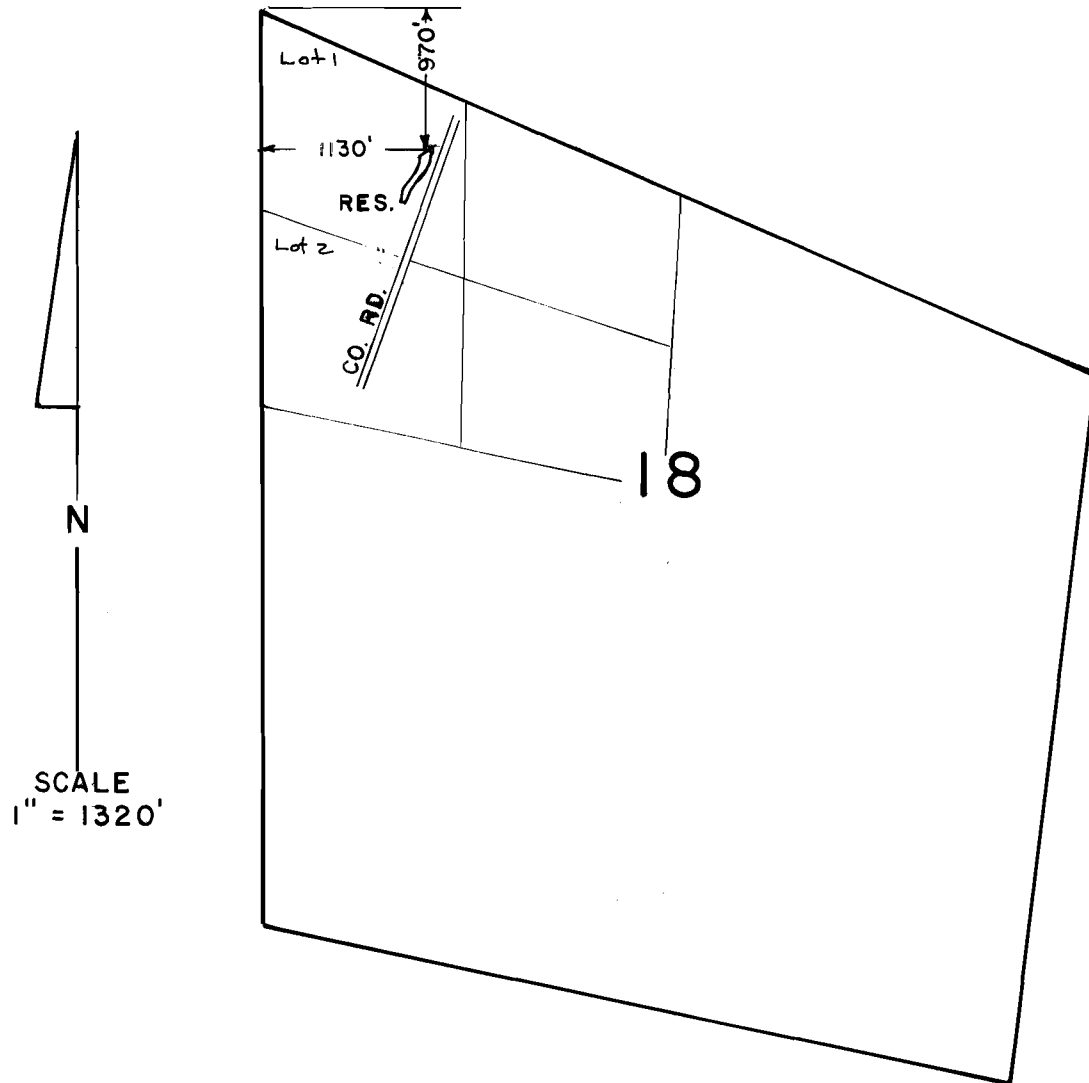

FINAL PROOF SURVEY
UNDER

R61293 R 8489
Application No. 63825 Permit No. 46980
IN NAME OF

EDGAR S. KLOCK

Surveyed MAY 23, 1984, by P. PAGTER