


T. 8S., R. 38E., W. M.

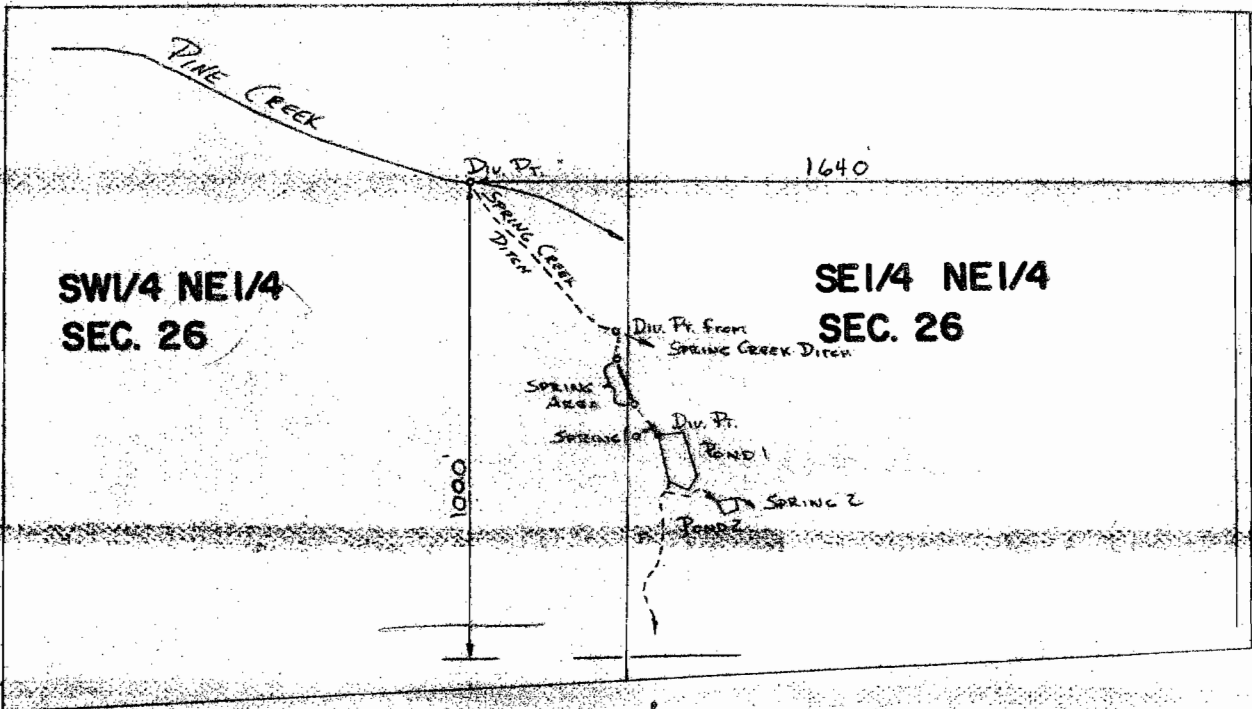

Div. Pt. Loc: 460' N. & 1240' W.

SPRING 1 Loc: 460' N. & 1290' W.

SPRING 2 Loc: 310' N. & 1090' W.

Div. Pt. from SPRING CREEK DITCH Loc:
680' N. & 1330' W.

FROM E/4 COR. SEC. 26



SCALE 1" = 400'

FINAL PROOF SURVEY

UNDER

64837

47506

64836

47441

R-64603

R-8649

Application No. R-64580 Permit No. R-8608.....

IN NAME OF

.....**DAVID L. PHILLIPS**.....

Surveyed 4-15 1987, by V.L. Church

Layout from Assessor Map
PFS-1987-PC