T. 36 & 37 S., R 2 W., W. M.

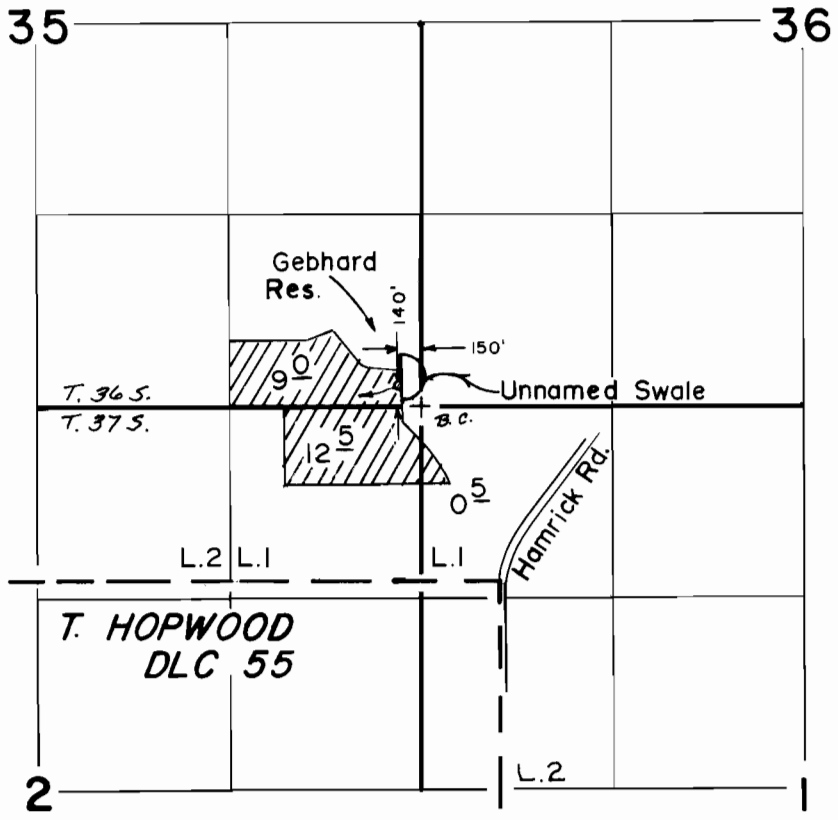

Scale: 1" = 1320'

FINAL PROOF SURVEY
UNDER

R-64597 R-8594

Application No. 64598 Permit No. 47320

IN NAME OF

GEBHARD ORCHARDS

Surveyed MAY 27 1986, by B. S. JAMES

41029-279-2442 LM1