


T. 36 & 37 S., R 2 W., W. M.

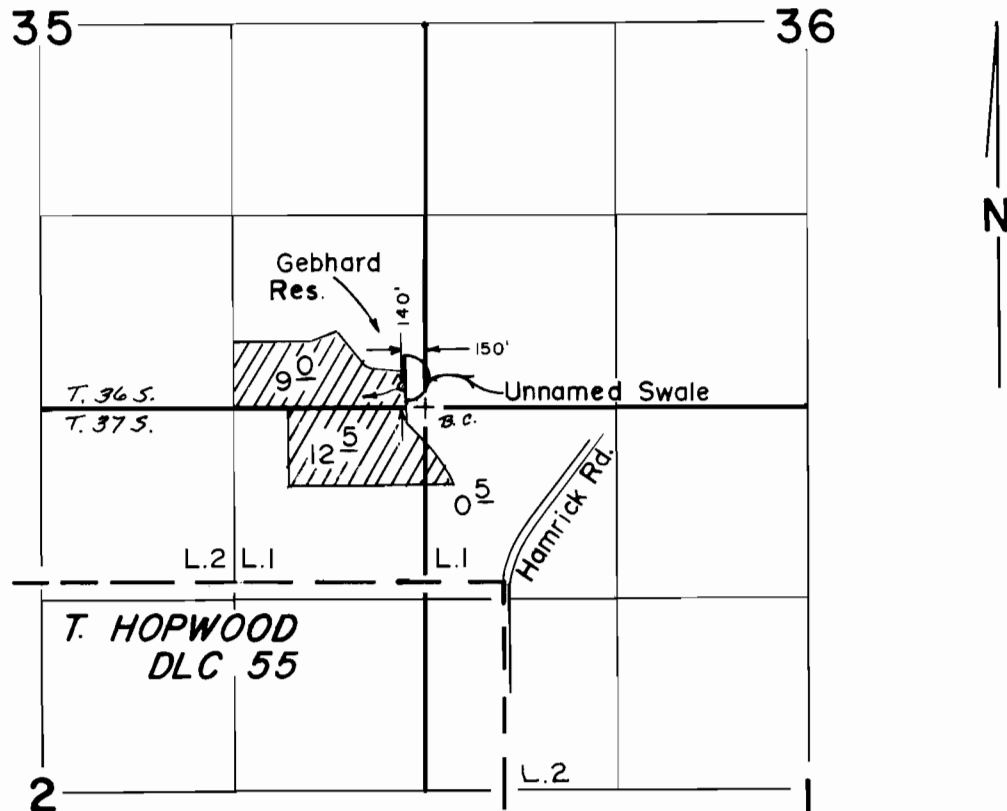

Scale: 1" = 1320'

**FINAL PROOF SURVEY**  
UNDER

R-64597                      R-8594  
Application No. 64598    Permit No. 47320  
IN NAME OF

GEBHARD ORCHARDS

Surveyed MAY 27 1986, by B. S. JAMES