


T. 37 S., R. 2 W., W. M.

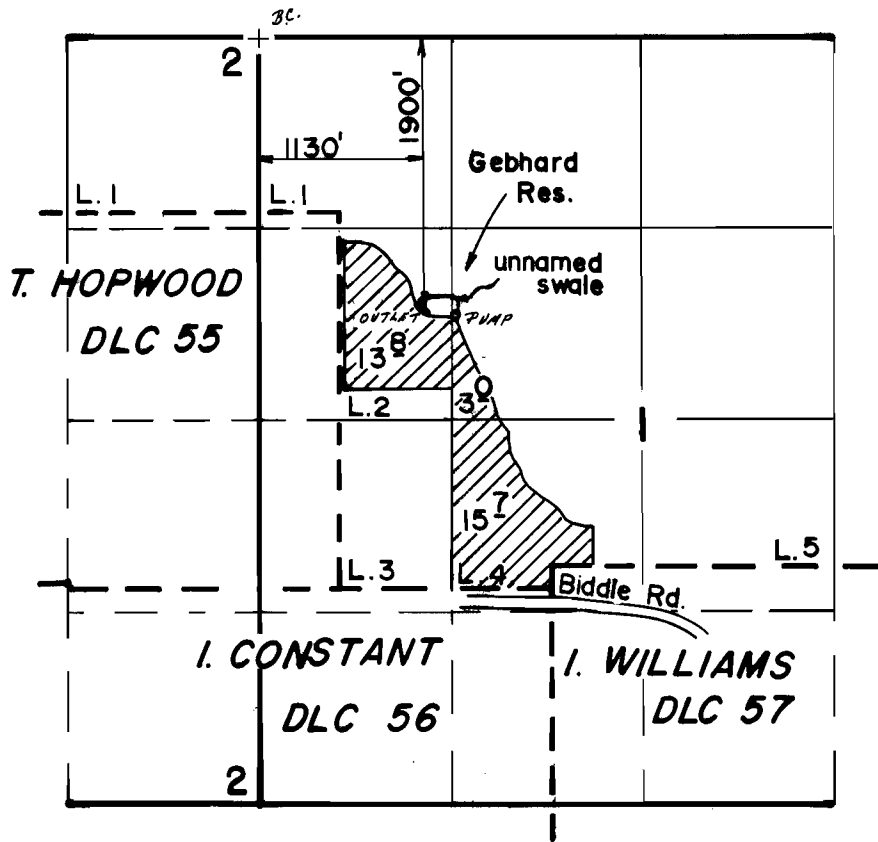

Diversion Points:

N. Fork Little Butte Cr. -
60' N., 630' W., from E1/4 cor. Sec. 20;

Scale: 1" = .1320'

S. Fork Little Butte Cr -
600' S., 525' W., from E1/4 cor. Sec. 29;

T. 36S., R. 2 E., W. M.

FINAL PROOF SURVEY
UNDER

R-68006

R-10022

Application No. 68007 Permit No. 48870

IN NAME OF

GEBHARD ORCHARDS

Surveyed MAY 28 1986, by B. S. JAMES.