


SEC 26, TOWNSHIP 8S., RANGE 38E. W.M.

1" = 400'

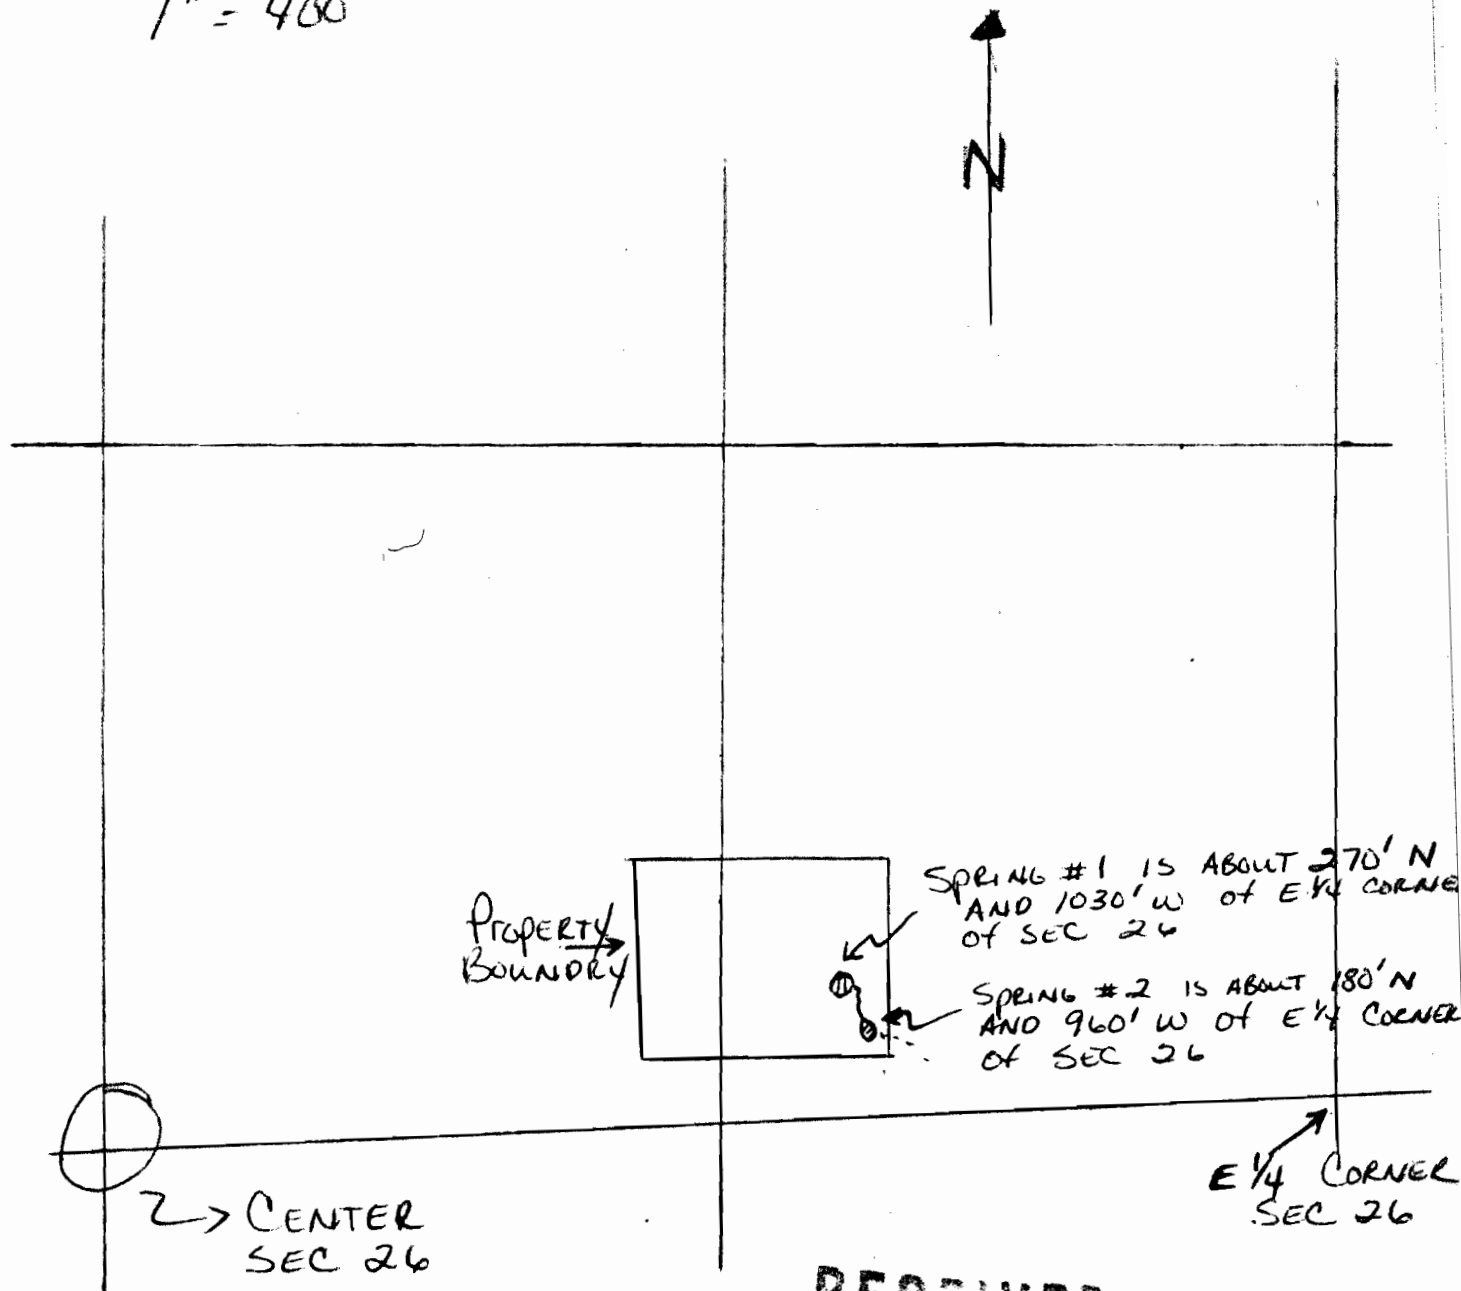

RECEIVED

MAR 25 1983

WATER RESOURCES DEPT.  
SALEM, OREGON

Application No. R-64603 & 64837

Permit No. R 8649

47506

SUPERSEEDING MAP FOR APPL. 64837, R-64603