


T6S. R8W. WM.

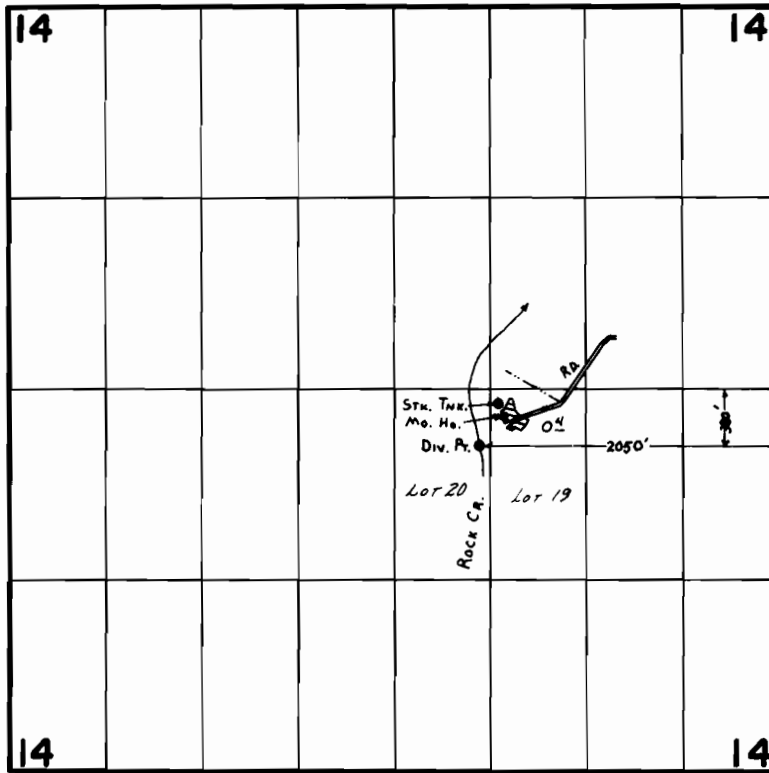

FINAL PROOF SURVEY UNDER

Application No. 52415... Permit No. 39425....
IN NAME OF

PAT WINKLER

Surveyed June 8... 1979, by C. L. HUGHES....