


T. 37 S., R. 6 W., W.M.

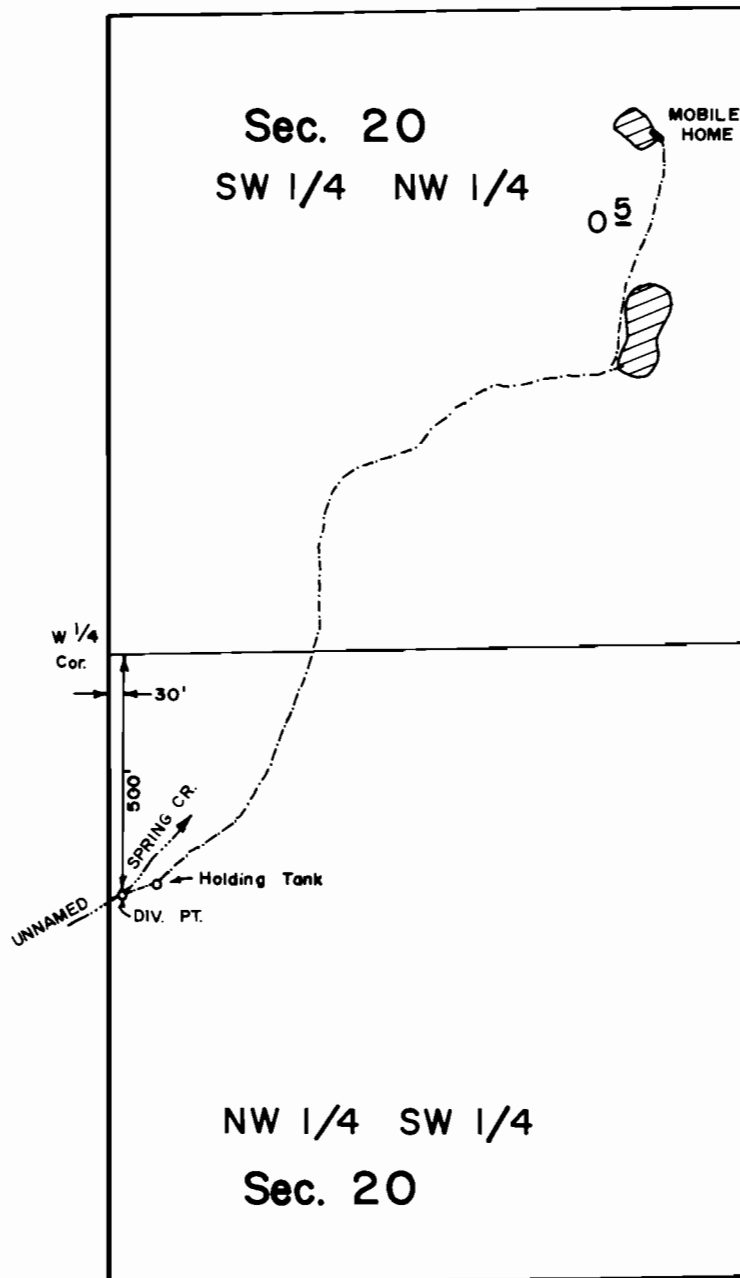

FINAL PROOF SURVEY
UNDER

Application No. **50588** Permit No. **39931**
IN NAME OF

Surveyed **Oct. 21, 1983**, by **B.S. JAMES**

Scale: 1" = 400'