


T.8S. R. 39E. W.M.

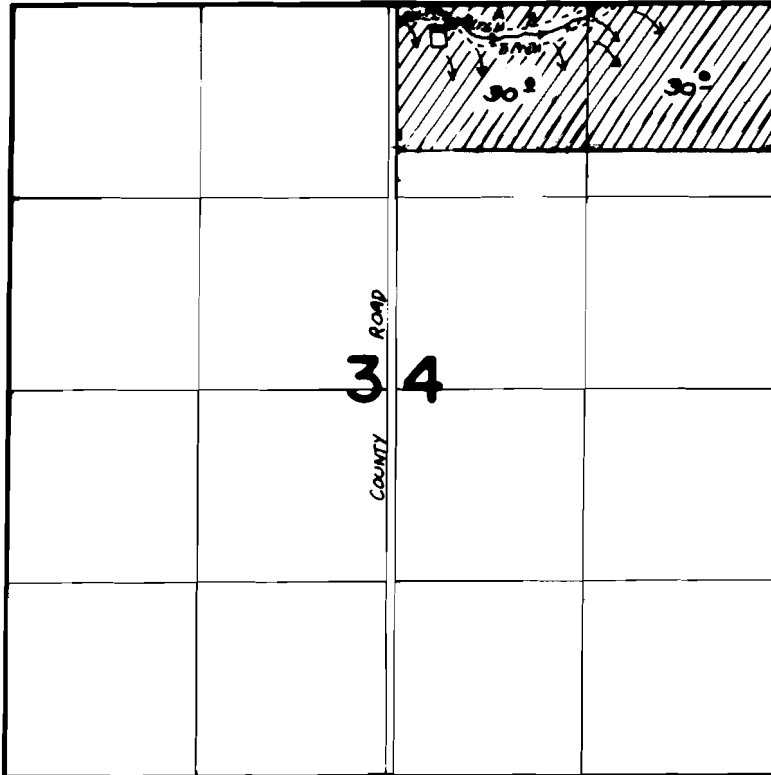

SCALE 1"=1320'



DIV. PT. LOCATED 110' S. AND 30' E. FROM N. 1/4 COR. SEC. 34

FINAL PROOF SURVEY UNDER

Application No. 54332 Permit No. 40732
IN NAME OF

FREEMAN ANGUS RANCH

Surveyed 5-21 1901, by V.L. CHURCH