


T. 34S., R. 6W., W.M.

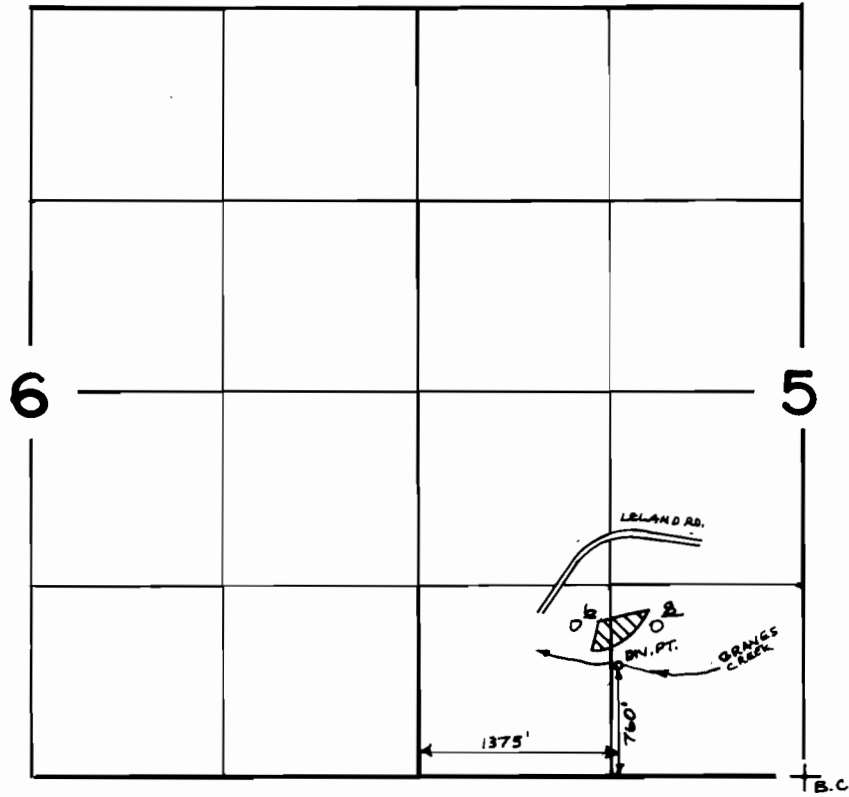

SCALE 1" = 1320'

**FINAL PROOF SURVEY**  
UNDER

Application No. 54728 Permit No. 41053  
IN NAME OF

HAZEL I. SMITH

Surveyed SEPT. 5 1984, by J.R. WOODROOF