


T.11S.,R.4W.,W.M.

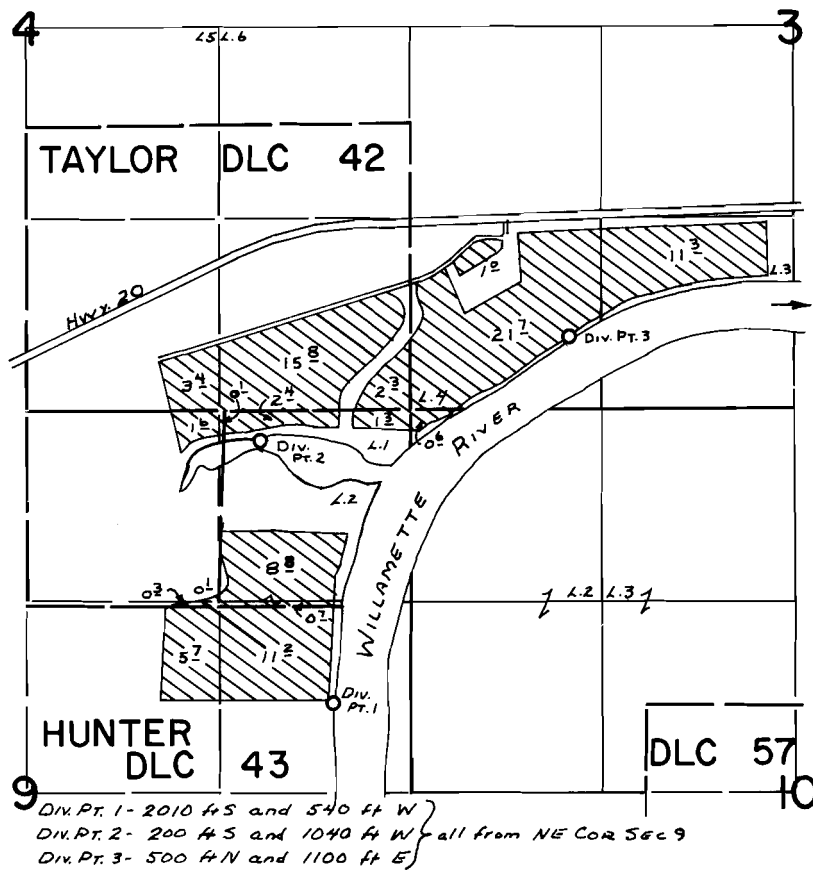

FINAL PROOF SURVEY UNDER

Application No. .55303. Permit No.41638.....
IN NAME OF

.....HILBERT HIGHLAND, INC.....

Surveyed Aug...25.. 19.82., by L.M.TOLL.....