


T.26S.,R.5W.,W.M.

Section 7

SW 1/4 SW 1/4

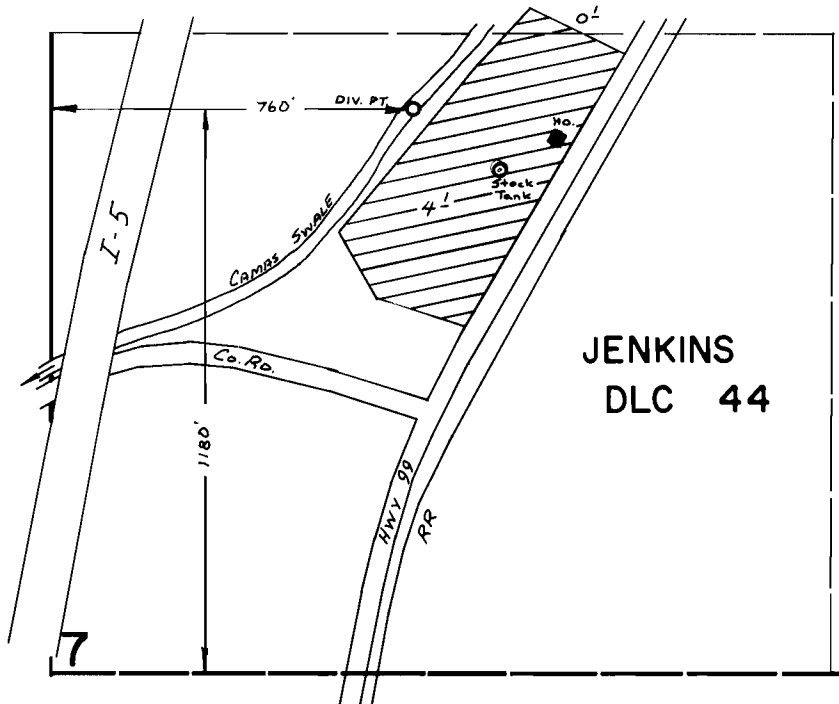

SCALE: 1" = 400'

FINAL PROOF SURVEY
UNDER

Application No. 56218 Permit No. 42163
IN NAME OF

ALICE ANN COLE

Surveyed Aug. 9 1982, by J. M. TOLL