


T. 38 S., R. 8 W., W. M.

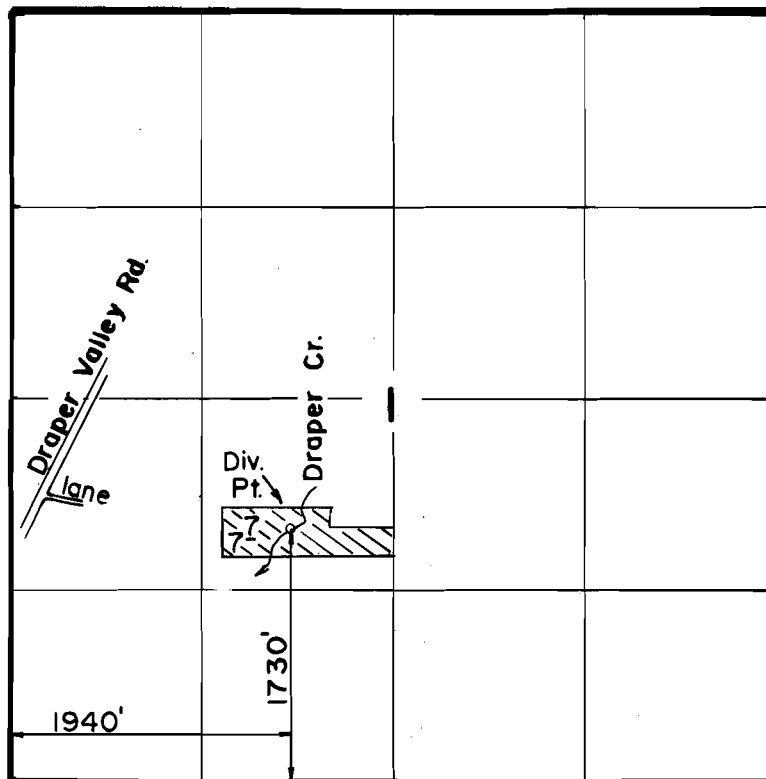

Scale: 1" = 1320'

FINAL PROOF SURVEY
UNDER

Application No. 56089 Permit No. 42274
IN NAME OF

FLOYD HUMBARD

Surveyed JUN. 18, 1986, by B. S. JAMES