


T. 39 S., R. 8 W., W.M.

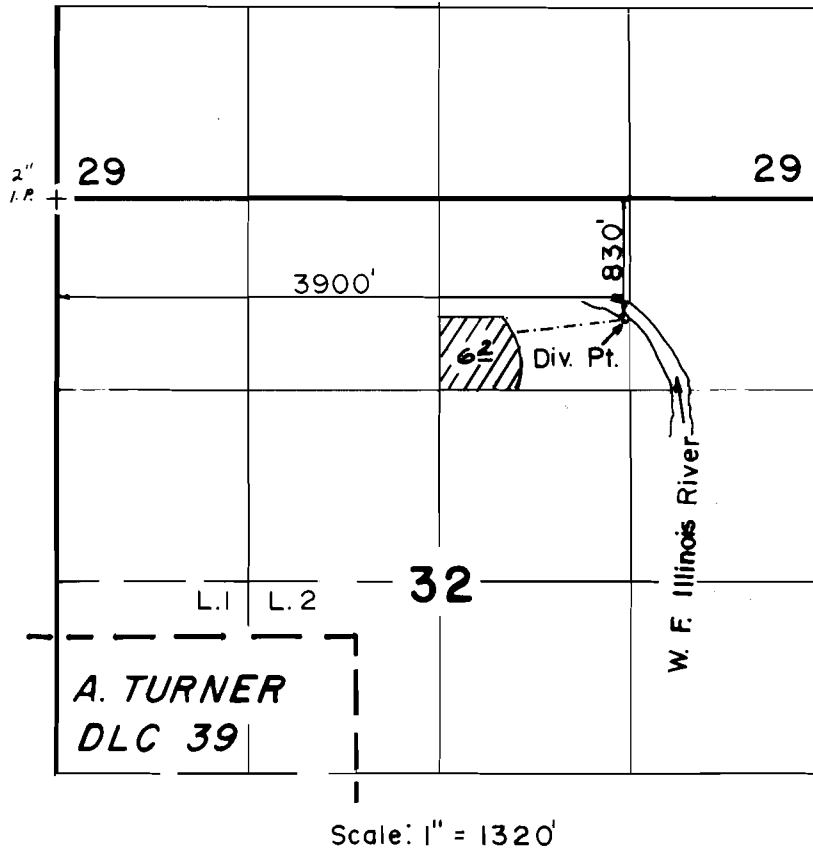

FINAL PROOF SURVEY
UNDER

Application No. 56655 Permit No. 42430
IN NAME OF

CHARLES VAU

Surveyed APR. 17, 1986, by B. S. JAMES