


T.3S., R.2W., W.M.

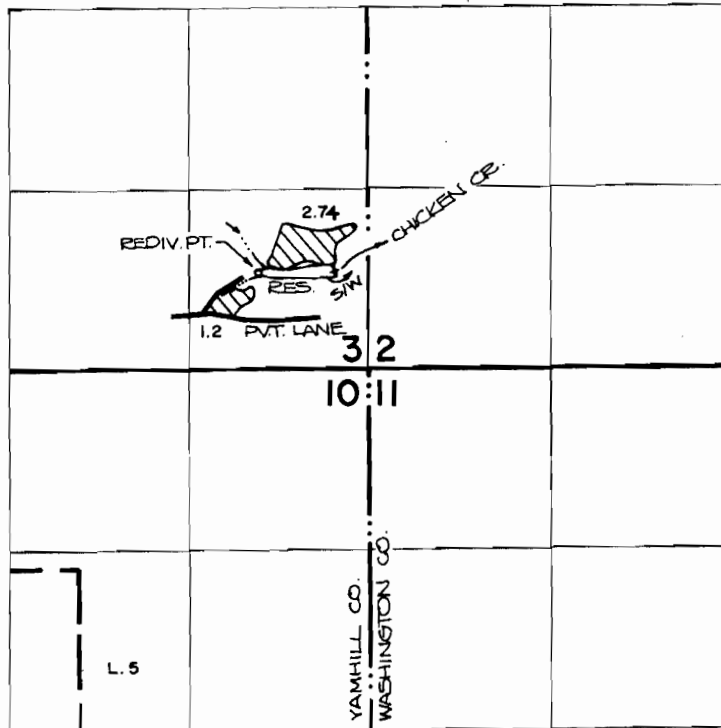

DAM LOCATION: 730 FT. N. AND 163 FT. W. FROM THE
S.E. CORNER OF SECTION 3.



FINAL PROOF SURVEY
UNDER

SCALE: 4" = 1 MILE

R-60814 R-8247
60815 45637
Application No. 56294. Permit No. 42501.....
IN NAME OF

.....ROBERT PAMPLIN, JR.....

Surveyed NOV. 14, 1984, by P. P. Patten.....