


T. 29 S., R. 4 W., W.M.

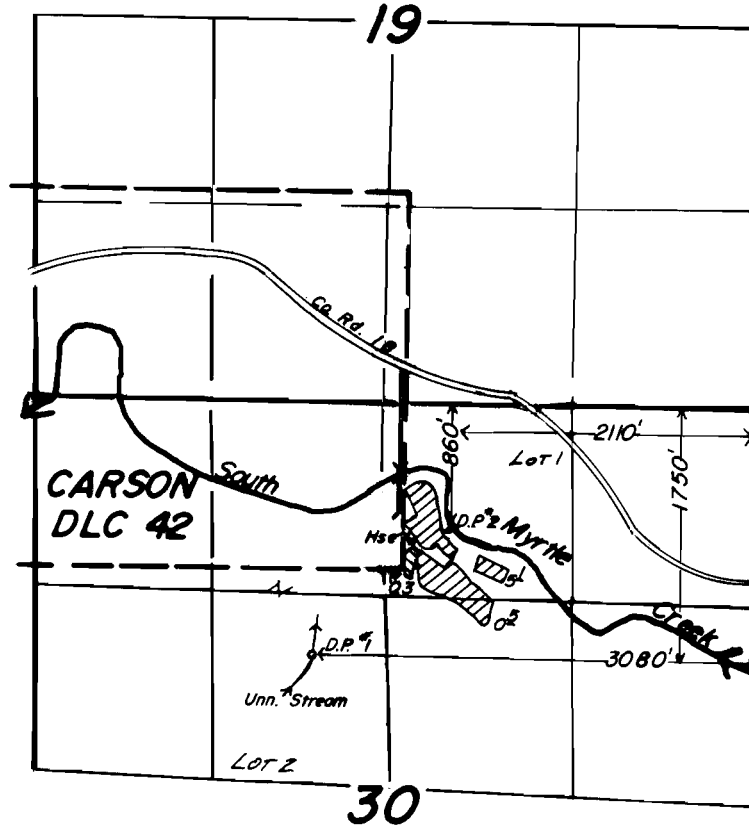

1" = 1320'

FINAL PROOF SURVEY
UNDER

Application No. 56911.... Permit No. ...42817.....
IN NAME OF

DANA R. or FRANCES I. PETTIBONE

Surveyed Sept. 5, 6, 1984, by Lynn Gashlan...