


T. 2 S., R. 9 W., W.M

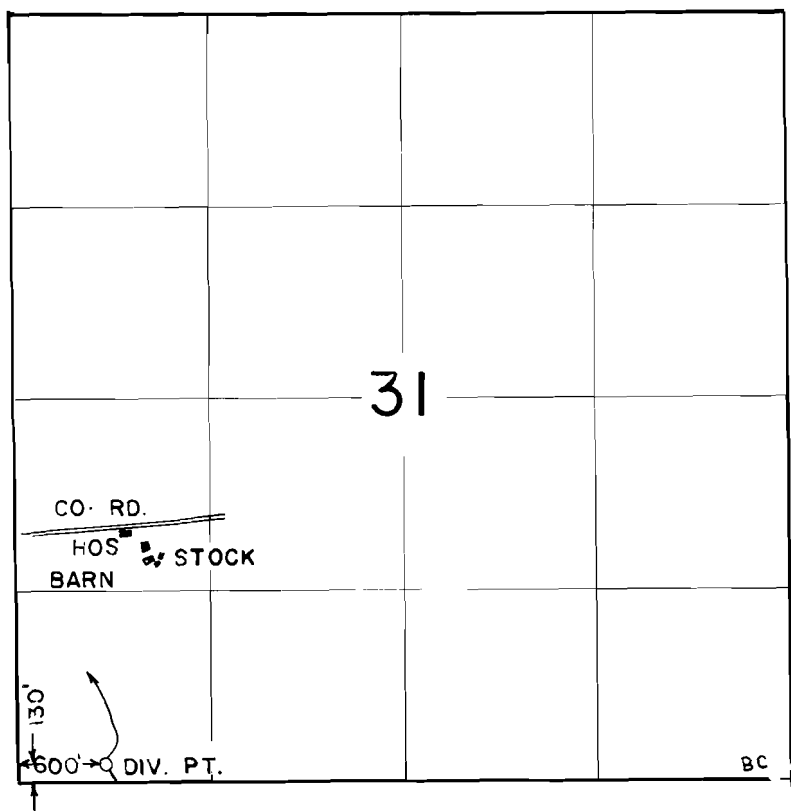

SCALE
1" = 1320'

FINAL PROOF SURVEY UNDER

Application No. 57254. Permit No. 43073.....
IN NAME OF

ELLA F. TRAMMELL.....

Surveyed JUL 30 1984, by P. PAGTER.....