
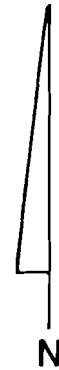


# T. 3 S., R. 9 W., W.M.

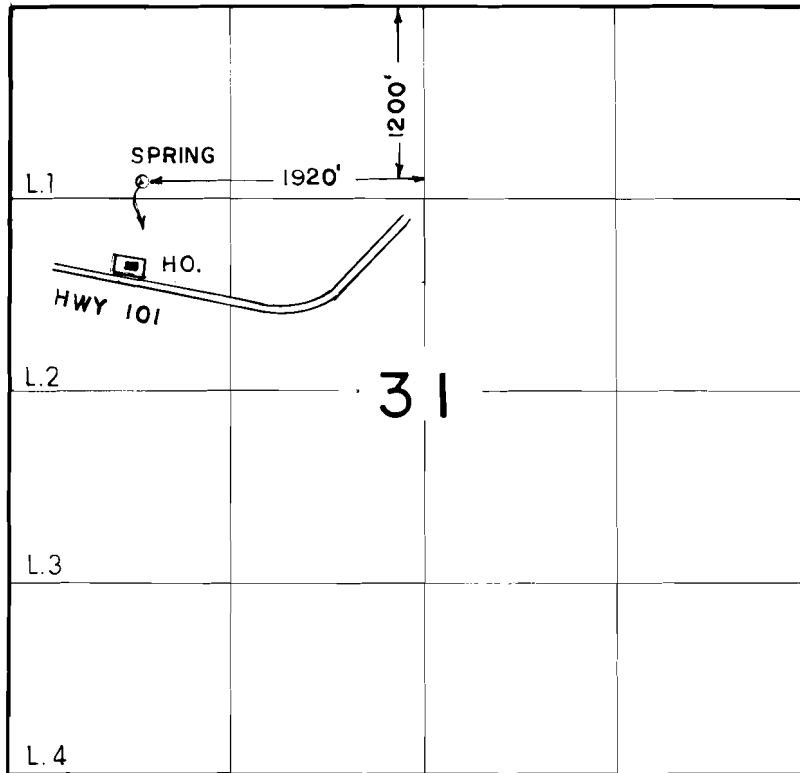

SCALE  
1" = 1320'

## FINAL PROOF SURVEY UNDER

Application No. 57377... Permit No. 43074.....  
IN NAME OF

ERWIN L. & ADELINE C. FRYE

Surveyed AUG. 1 1984, by P. PAGTER.....