


T. 38S., R. 8W., W.M.

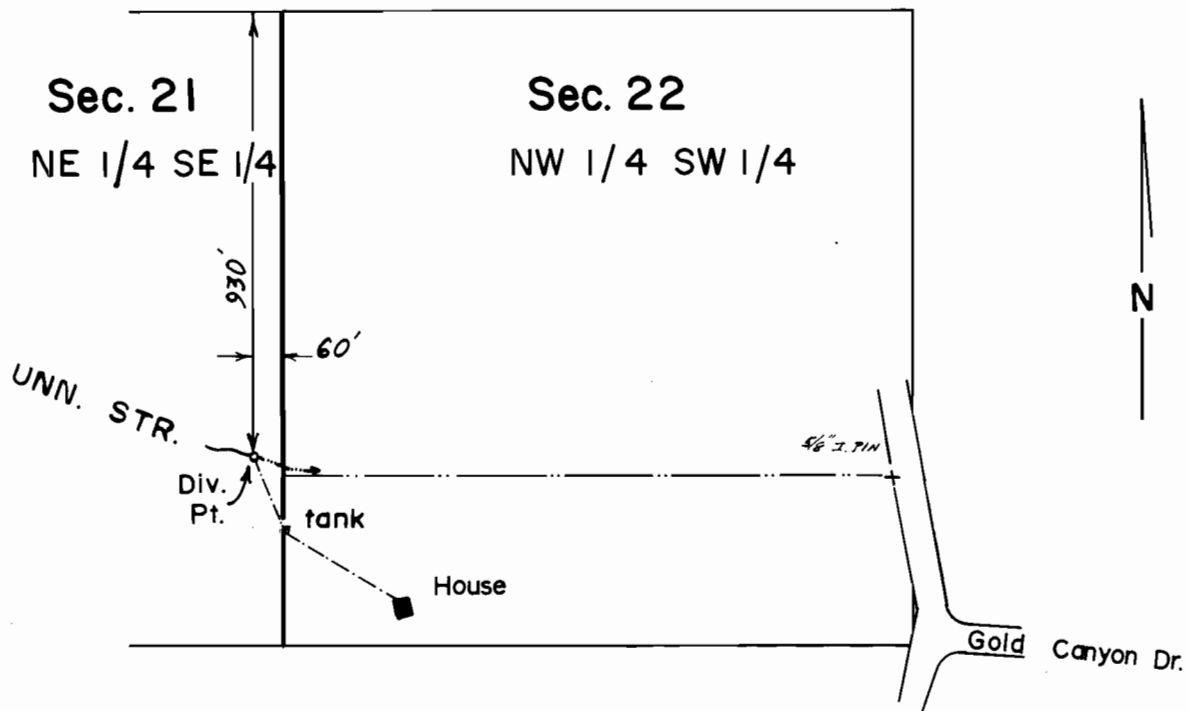

Scale 1" = 400'

FINAL PROOF SURVEY
UNDER

Application No. 57253 Permit No. 43111
IN NAME OF

FRANK PEDELINI

Surveyed Nov. 7, 1984, by J.R. WOODROOF