


# T.19S., R.12W., W. M.

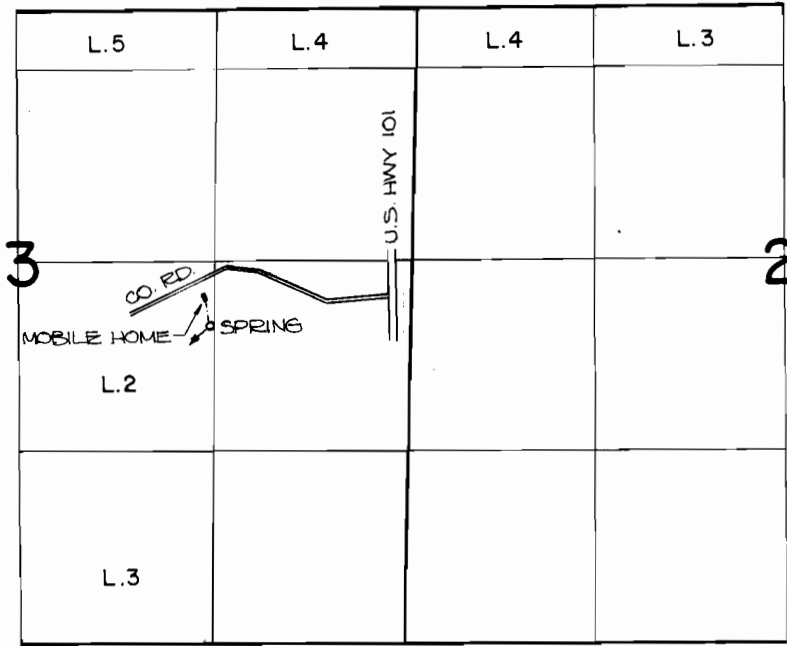

SPRING LOCATION: 440 FT. S. AND 1300 FT. E. FROM THE CENTER OF SECTION 3.

## FINAL PROOF SURVEY UNDER

Application No. 57424 Permit No. 43167  
IN NAME OF

JOHN A. BEATY

Surveyed JULY 17, 1984, by P. Pagten



SCALE: 4" = 1 MILE