


Application No. 57624
Permit No. 43208

Job # 3S2W, S3NW-1

SURVEY OF LOT 25, "CHEHALEM HILL"
in the NW $\frac{1}{4}$, of Section 3, T 3 S, R 2 W, W.M.
for McTimmonds

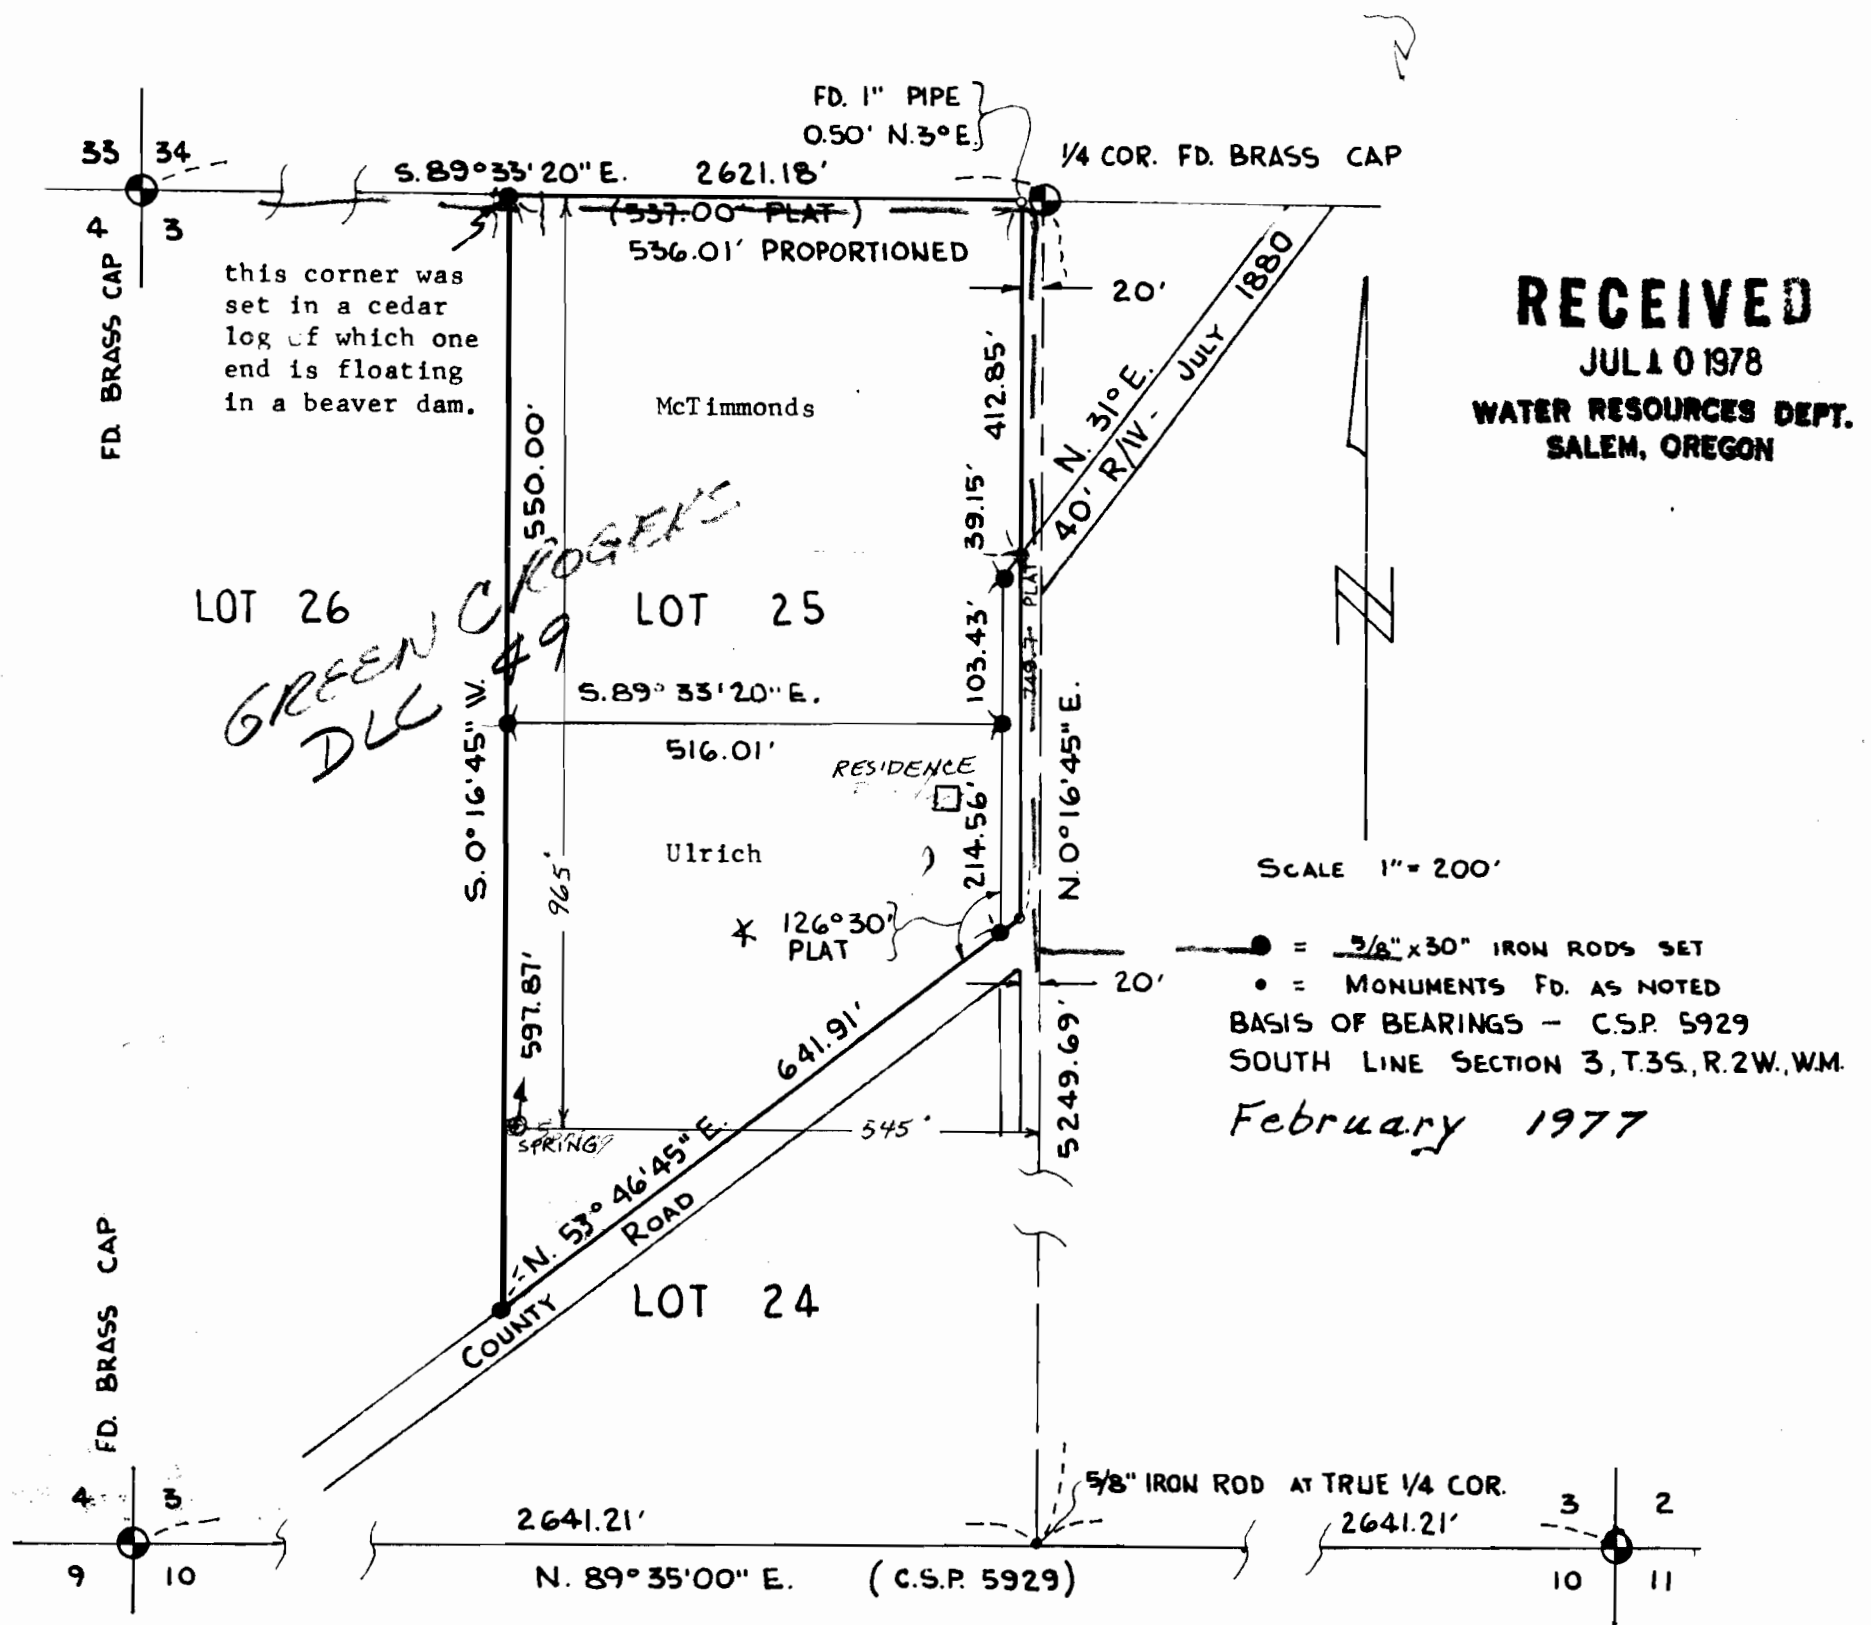

REGISTERED
PROFESSIONAL
LAND SURVEYOR

Hermit H. Carlick

OREGON
JULY 17, 1970
KERMIT H. CARLILE
821

KERMIT H. CARLILE
PROFESSIONAL LAND SURVEYING
OREGON - WASHINGTON
RT. 3, BOX 278 M
SHERWOOD, OREGON 97140

Ph. 503 - 625-7046