


T.35 S., R.2 W., W.M.

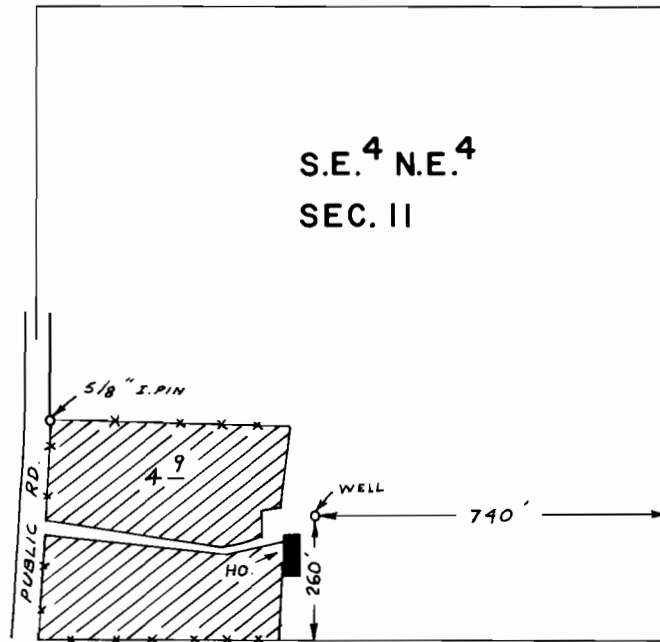

SCALE : 1" = 400 FT.

FINAL PROOF SURVEY
UNDER

Application No. G-6317 Permit No. G-5933
IN NAME OF

ROBERT A. & NORMA R. NEILL

Surveyed APR. 27 1979, by B. SUND