


T.18S., R.10W. WM.

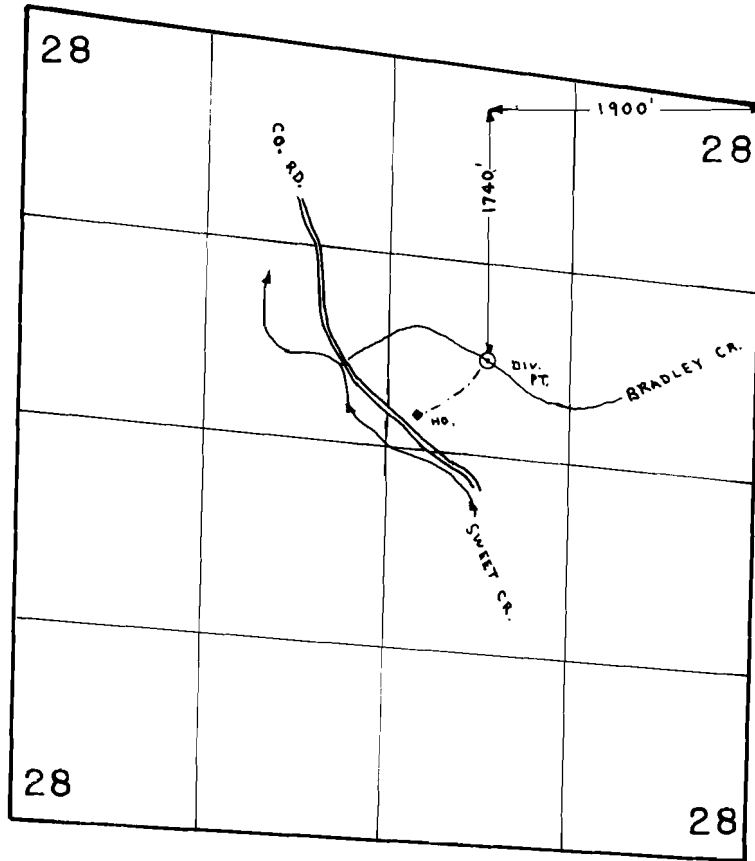

FINAL PROOF SURVEY
UNDER

Application No. 58199 Permit No. 43855.....
IN NAME OF

JOHN LEE HAWKINS.....

Surveyed NOV. 13, 1983, by P. PAGTER.....