


T.32S., R.6W., W.M.

SEC. 26

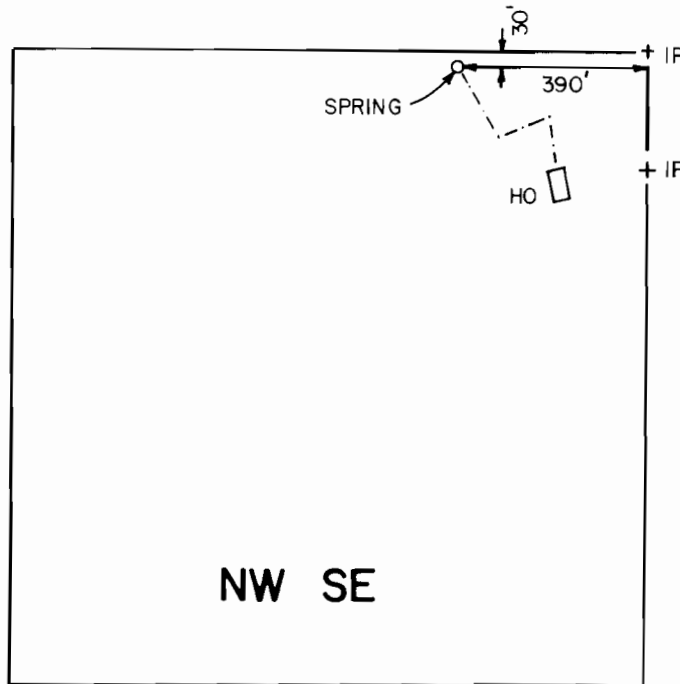

SCALE: 1" = 400'

FINAL PROOF SURVEY
UNDER

Application No. 58113... Permit No. 43895...
IN NAME OF

MITCHELL RYAN SWANSON

Surveyed AUG...22, 1984, by J.E. Cashion