


# T.24S. R.5W. W.M. SECTION 15

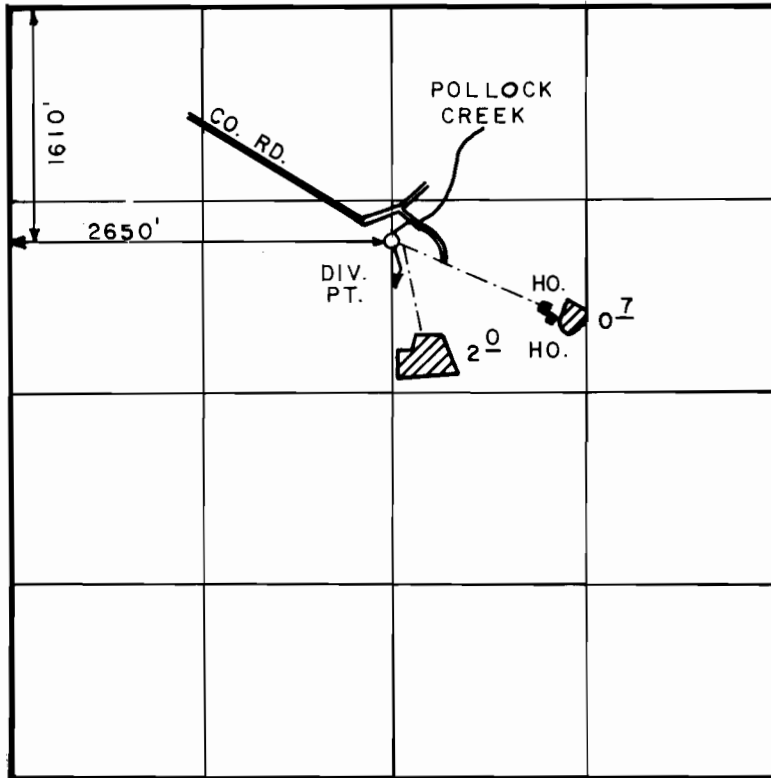

SCALE: 4" = 1 MILE

## FINAL PROOF SURVEY UNDER

Application No. 59181... Permit No. 44445...  
IN NAME OF

**MARK EDWARD VINCENT & DAVID W. REYNOLDS**

Surveyed OCT. 16 1986, by J.M. SCHMORDE