


T. 3 S. R. 5 W. W.M.

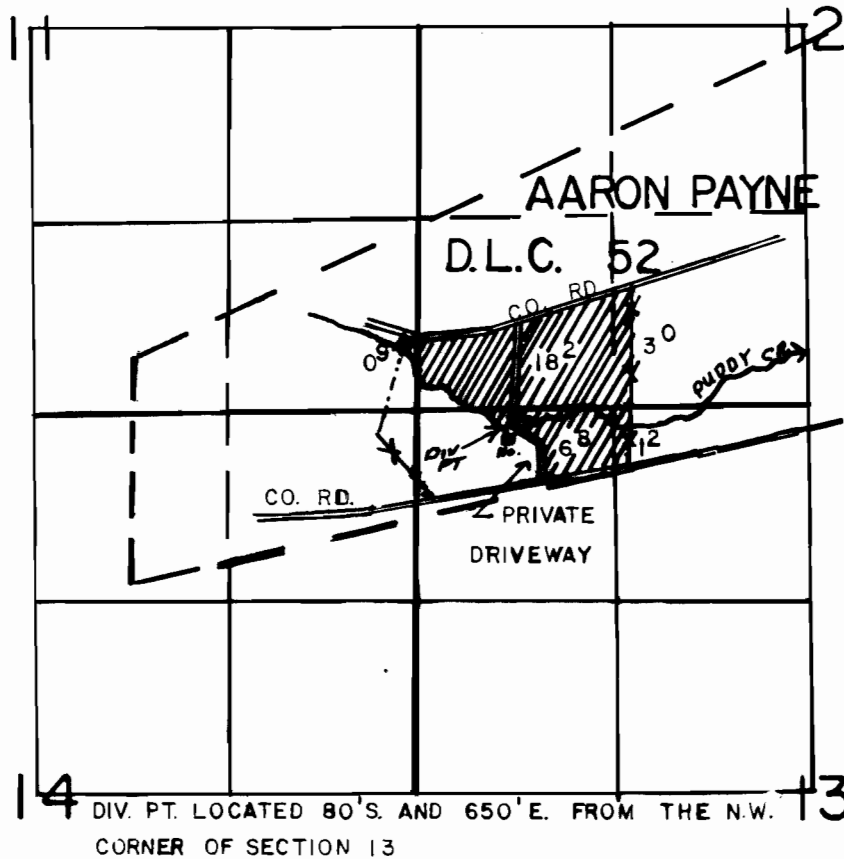

FINAL PROOF SURVEY
UNDER

Application No. **5.9334** Permit No. **44469**
IN NAME OF

D. V. A.

Surveyed NOV. 9, 1983, by R. PAGTER