
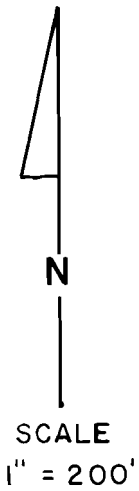


T. 1 S., R. 8 W., WM.

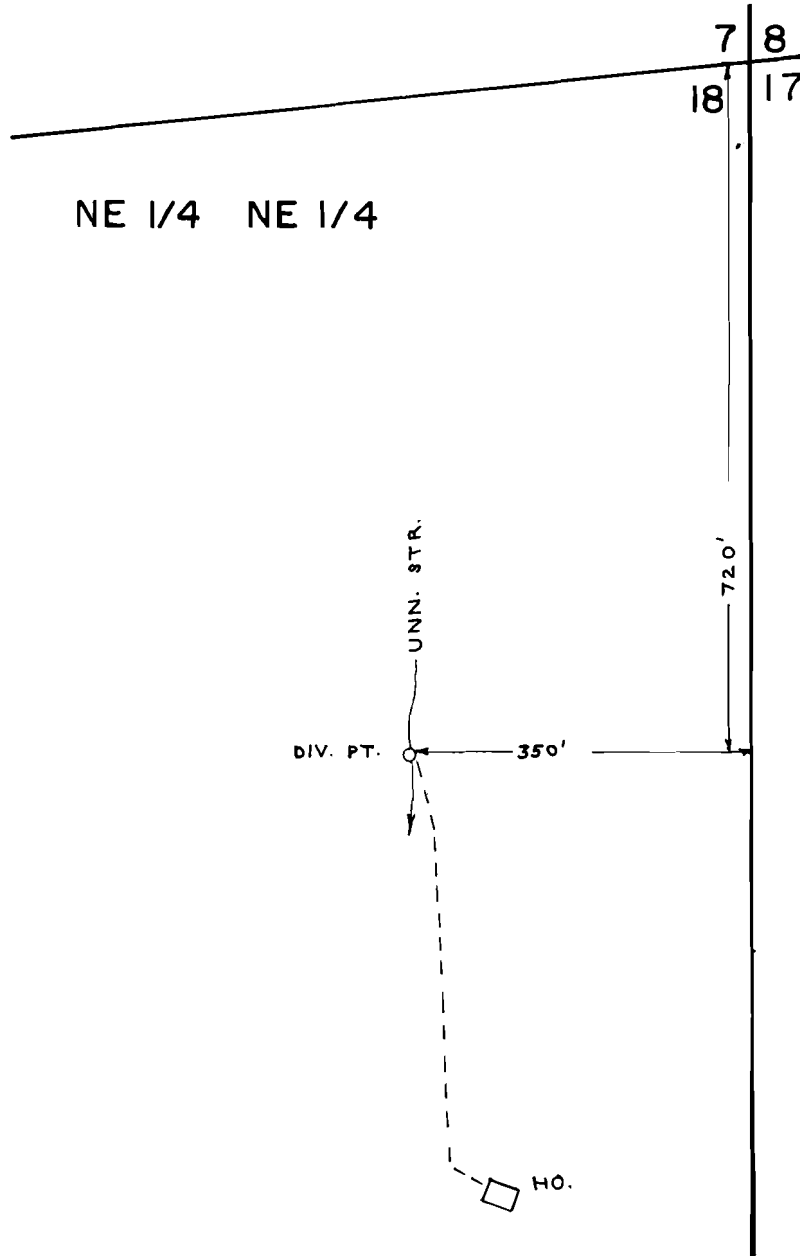

FINAL PROOF SURVEY
UNDER

Application No. 60102 Permit No. 44861.....
IN NAME OF

RONALD KASER & JUDITH BALES

Surveyed JUN. 12. 1984. by P. PAGTER.....