


T.16S.,R.5E.,W.M.

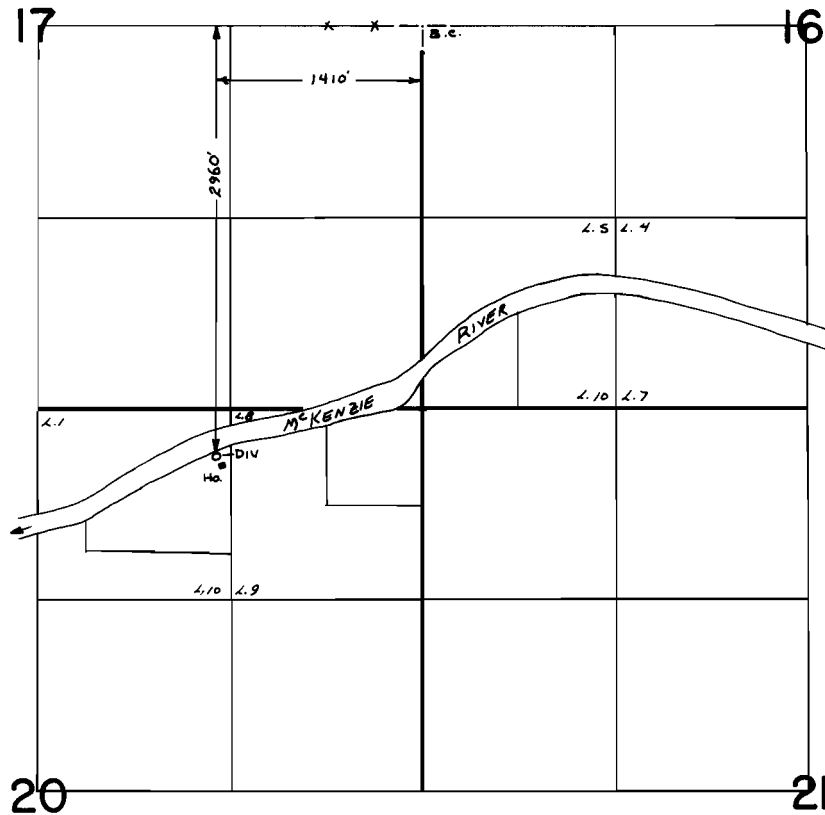

FINAL PROOF SURVEY
UNDER

Application No. ..59677.. Permit No. ..44887.....
IN NAME OF

.....RALPH & ELLEN CORE.....

Surveyed Aug...18... 1981... by S.C. BROWN.....