


T. 2S., R. 1W., W.M.

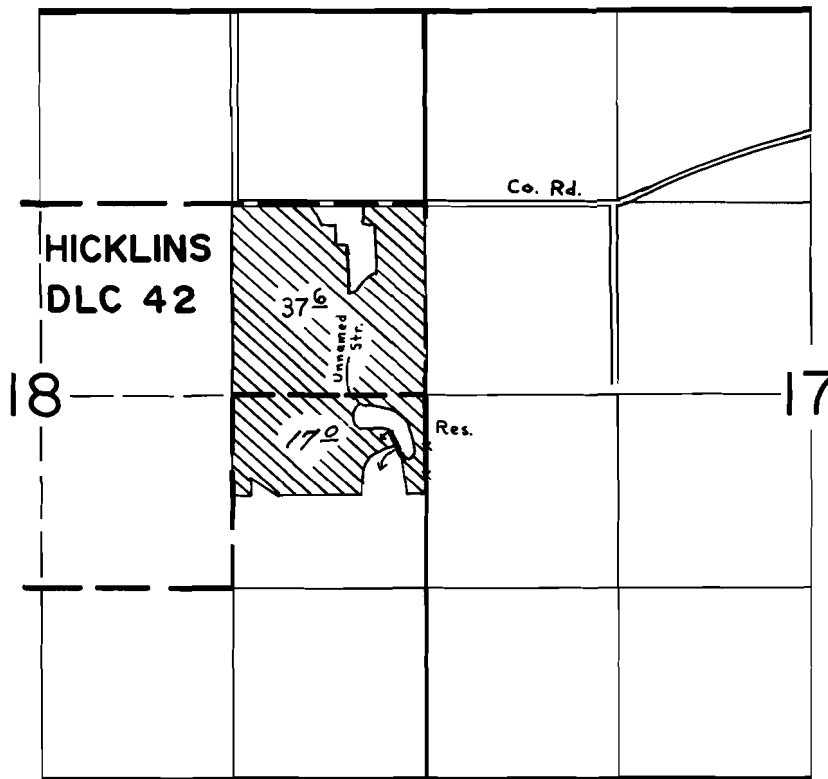

Dam Loc: 2270' N. & 200' W. fr. S.E. Cor. Sec. 18

SCALE: 1" = 1320'

FINAL PROOF SURVEY
UNDER

R-59927 R-8279
Application No. 59928 Permit No. 45854
IN NAME OF

PORTER-WALTON CO., INC.

Surveyed NOV. 17, 1983, by L. TOLL